

PASSIVE SAMPLING PILOT STUDY REPORT

STRINGFELLOW HAZARDOUS WASTE SITE

July 2009

SUBMITTED TO:

**California Department of Toxic Substances Control
8810 Cal Center Drive, Second Floor
Sacramento, California 95826**

PREPARED BY:

**GeoLogic Associates
1831 Commercenter East
San Bernardino, California 92408
(909) 383-8728**

In Association with:

**Bryan A. Stirrat & Associates
1360 Valley Vista Drive
Diamond Bar, California 91765**



Geo-Logic
ASSOCIATES




PREFACE

GeoLogic Associates is a contractor for the Groundwater Monitoring Program at Stringfellow Hazardous Waste Site (Stringfellow Site), Riverside County, California. This work was performed for the State of California, Department of Toxic Substances Control, contract number 00-T2122.

This document provides results obtained for groundwater samples that were collected as part of a passive sampling pilot study at the Stringfellow Site during March 2008, and compares these results with analytical data obtained for samples that were collected using traditional purge-and-sample methods during the Spring 2008 and Fall 2008 monitoring events.

GeoLogic Associates personnel involved in the program include Mr. Michael Reason, PG, CHg, who serves as the Project Manager, and Mr. Eric White, PG, CHg who serves as Project Geologist. Ms. Carol Wilson is the DTSC Project Manager.


Approved:

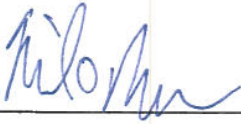

Michael D. Reason, PG, CHg
Senior Hydrogeologist



Eric White, PG, CHg
Project Geologist

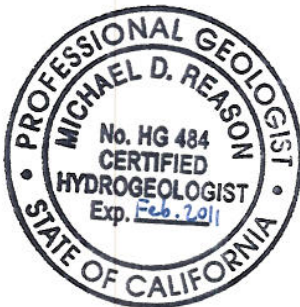

EXECUTIVE SUMMARY

This report presents a summary of a passive sampling pilot study that was performed at the Stringfellow Hazardous Waste Site (Stringfellow Site) to evaluate if there is depth-discrete differences in samples collected with a sampling device that employs passive sampling technology, and determine if the concentrations from the depth-discrete passive sampling devices are comparable with the results obtained from samples that are collected using traditional purge-and-sample techniques. This report summarizes the results from the two sampling methods and provides recommendations for future sampling events.

For this study, passive Hydrasleeve™ sampling devices were deployed in six wells and allowed to equilibrate for 49 to 50 days. To evaluate possible variation in concentrations with respect to variations in permeability or preferential contaminant pathways due to variation in aquifer materials, multiple Hydrasleeve™ sampling devices were deployed in each well. Three passive samplers were deployed at vertically discrete intervals in two wells, and four samplers were deployed at vertically discrete intervals in four wells. The depth of deployment was based on permeable zones as determined from boring logs and the available saturated zone within a well at the time of deployment. The passive samples were tested for perchlorate by EPA Method 314.0 and IC-MS/MS, and VOCs by EPA Method 8260. Analytical results obtained from the passive samples were compared with results for the Spring 2008 and Fall 2008 monitoring events, which employed traditional purge and sample methodology.

Based on the results from the study, it is concluded that the Hydrasleeve™ passive sampling devices provide similar results as samples collected using traditional purge and sample methods, as summarized below:

- Analytical results from one well (CTS-OW3) indicated some vertical stratification for perchlorate, with the highest concentrations reported in the deepest sample. No apparent vertical stratification was noted for perchlorate in the other wells, nor for VOCs in any of the wells.
- The samples from two wells (OC-11B and OW-68D1) required dilution before testing by EPA Method 314.0 because of matrix interference, which resulted in detection limits that were higher than the analytical results provided by the IC-MS/MS test method. Based on the average result from the EPA Method 314.0 testing and IC-MS/MS testing for the other 14 passive samples, the reported analytical result for a specific test method was within 5 percent of the average concentration for 8 samples, within 5 to 8 percent for 4 samples, and within 11 percent for the remaining 2 samples.
- For EPA Method 314.0 testing, the average perchlorate concentrations reported for the passive samples differed from the results from the Spring 2008 sampling by less than 13 percent for 3 samples. However, the concentrations for CTW-OW3 differed by 60 percent due to the relatively high concentrations reported for the deepest passive sample.

- Differences between IC-MS/MS analytical results for the average concentration from passive samples and the concentration from the Fall 2008 sampling event ranged from 0 to 15 percent.
- For detected VOCs, the analytical results for the passive samples were generally within 10 percent of the results for samples collected using traditional purge and sample techniques.
- The differences in concentrations reported for the pumped and passive samples can be partly explained by the elapsed time between sampling events (1 to 8 months).

Based on the conclusions described above and the information obtained during sample collection, the following recommendations have been developed:

- Little variability was noted for depth-discrete samples in a single well. Therefore, it appears to be sufficient to collect one sample in the middle of the saturated screen interval, although the local geology should be evaluated in wells that span several geologic units (alluvium and bedrock, for example).
- The sample volume provided by the passive sampling devices (less than 0.7 liters for a 2-inch device; approximate 1.6 liters for a 4-inch device) may limit the analytical suite, but this limitation could be overcome by deploying multiple Hydrasleeve™ devices in a single well if an expanded analytical suite is planned.
- Retrieval of Hydrasleeve™ sampling devices from open borehole wells should be performed with caution owing to the potential for tearing of the device on rough bedrock walls or the bottom of the protective surface casing.
- If additional comparisons between sampling methods are performed, the temporal difference between the two samples should be minimized. Optimally, the passive samples should be collected immediately prior to purging of the well for samples collected using traditional purge-and-sample techniques.

TABLE OF CONTENTS

1.0 INTRODUCTION.....1-1
 1.1 BACKGROUND1-2
 1.2 MONITORING PROGRAM OBJECTIVES1-3
 1.3 REVIEW OF PASSIVE SAMPLING TECHNOLOGY1-3

2.0 SAMPLING PROCEDURES2-1
 2.1 SAMPLE LOCATIONS2-1
 2.2 SAMPLING PROCEDURES2-1
 2.3 QUALITY ASSURANCE/QUALITY CONTROL SAMPLES2-2
 2.4 LABORATORY TESTING AND DATA VALIDATION2-2

3.0 MONITORING RESULTS.....3-1
 3.1 PASSIVE SAMPLER DEPLOYMENT AND MONITORING RESULTS3-1
 3.2 PERCHLORATE TEST METHOD COMPARISON3-3
 3.3 SAMPLING METHOD COMPARISON3-4

4.0 CONCLUSIONS AND RECOMMENDATIONS.....4-1
 4.1 CONCLUSIONS.....4-1
 4.2 RECOMMENDATIONS4-2

5.0 REFERENCES.....5-1

LIST OF TABLES

Table 2-1 Well Locations and Depth of Hydrasleeve™ Deployment
 Table 3-1 Summary of Analytical Results

LIST OF FIGURES

Figure 1-1 Project Location Plan
 Figure 1-2 Site Vicinity
 Figure 1-3 Location of Zones 1-4
 Figure 1-4 Index Map – Passive Sampler Pilot Study, May 2008
 Figure 1-5 Zones 1A and 1B Well Location Map
 Figure 1-6 Zones 2 and 3 Well Location Map
 Figure 1-7 Upgradient Zone 4 Well Location Map
 Figure 1-8 Downgradient Zone 4 Well Location Map
 Figure 3-1 Well OC-11B Results
 Figure 3-2 Well OW-68D1 Results
 Figure 3-3 Well MW-9B Results
 Figure 3-4 Well LEO-11A Results
 Figure 3-5 Well CTS-OW3 Results

TABLE OF CONTENTS (Continued)

LIST OF FIGURES (Continued)

Figure 3-6	Well FC-1020A Results
Figure 3-7	Comparison of Perchlorate Concentrations in Passive Samples
Figure 3-8	Comparison of Perchlorate (EPA Method 314.0) Concentrations
Figure 3-9	Comparison of Perchlorate (IC-MS/MS) Concentrations
Figure 3-10	Comparison of PCE Concentrations
Figure 3-11	Comparison of TCE Concentrations
Figure 3-12	Comparison of Chloroform Concentrations

APPENDIX A

Lithologic logs

APPENDIX B

Field Data Sheets

APPENDIX C

Laboratory Analytical Reports

APPENDIX D

Data Validation Report

APPENDIX E

Time-Series Charts

APPENDIX F

Comments and Responses

1.0 INTRODUCTION

This report presents a summary of a passive sampling pilot study that was performed at the Stringfellow Hazardous Waste Site (Stringfellow Site). As requested by the State of California Department of Toxic Substances Control (DTSC), groundwater samples were collected using Hydrasleeve™ passive sampling devices from two wells in Zone 1B, one well in Zone 2, one well in Zone 3, and two wells in Zone 4. Field activities were conducted in general accordance with the standard operating procedures in the Groundwater Monitoring Program Work Plan (Groundwater Monitoring Work Plan) (GeoLogic Associates (GLA), 2001), except the wells were not purged and sampled as stated in Sections 3.3 and 3.4 of the Groundwater Monitoring Work Plan. Instead, samples were collected using passive sampling devices that were deployed at depth-discrete intervals (LeBlanc and Vroblesky, 2008). Laboratory analyses were completed in accordance with the quality assurance plan that is detailed within Appendices A, B, and C of the Groundwater Monitoring Work Plan.

Section 1.0 of this report provides a brief background of the Stringfellow Site and an overview of the site monitoring program.

Section 2.0 summarizes field data collection activities, including the groundwater monitoring wells that were sampled, and sampling procedures associated with the Hydrasleeve™ sampling devices.

Section 3.0 provides a summary of the sampling and laboratory analytical data validation performed by the Laboratory Data Consultants (LDC) for the passive sampling event.

Section 4.0 summarizes the laboratory analytical results from samples collected in March 2008 using the passive sampling techniques and compares these results with the analytical results from the April 2008 routine monitoring event, which employed purging methodology from the Groundwater Monitoring Work Plan.

Section 5.0 provides a list of references used in this report.

Appendix A provides lithologic logs of the wells included in this program.

Appendix B provides field data sheets that were completed at the time of sampling.

Appendix C provides laboratory certificates of analysis.

Appendix D provides a data validation report prepared by laboratory data consultants.

Appendix E provides time-series charts showing historical monitoring results for the tested wells.

Appendix F provides a comments and response matrix for the draft version of this report.

1.1 BACKGROUND

The Stringfellow Site is a former Class I industrial waste disposal facility located approximately 50 miles east of the City of Los Angeles in southern California (Figure 1-1). The Stringfellow Site is located at the northern edge of Riverside County near the community of Glen Avon (Figures 1-2, 1-3, and 1-4). During its operation from 1956 to 1972, the Stringfellow Site contained as many as 20 surface impoundments to contain and evaporate liquid chemical wastes. About 34 million gallons of liquid industrial process wastes containing spent acids and caustics, solvents, pesticide by-products, metals, and other inorganic and organic constituents were discharged into the site's evaporation ponds during the site's operating life.

After operation for 16 years as an industrial waste disposal facility, the Stringfellow Site stopped accepting wastes in November 1972. From the time that heavy rains in March 1969 first caused impacted surface overflow downstream into Glen Avon, the Stringfellow Site operators had faced a growing number of indications that the facility was not in compliance with waste discharge requirements that had been established by Riverside County and the California Regional Water Quality Control Board, Santa Ana Region (RWQCB). By 1975, all efforts by the site operator to re-open the facility were exhausted and, after the operator was unable to undertake site closure, the RWQCB declared the Stringfellow Site a nuisance. An interim abatement effort was initiated in 1980 after completion of a series of engineering assessments of closure options. The interim abatement included removal of all surface ponds, construction of a subsurface barrier wall on the downgradient side of the site, installation of a surface cover and other drainage control features, and installation of several on-site and downgradient groundwater monitoring wells. The period just prior to initiation of the interim abatement (1977-1980) was marked by three years of heavy rainfall, which resulted in an overflow into the Glen Avon community.

The Stringfellow Site was placed on the Superfund National Priority List (NPL) in 1982 and was, at the same time, declared California's highest priority toxic waste site. In October 1983, the California Department of Health Services declared the Stringfellow Site an "imminent or substantial endangerment to the public health and the environment," reinforcing a May 1983 finding by the U.S. Environmental Protection Agency (EPA) in its lawsuit filed against the Responsible Parties.

At the present time, an active groundwater pump-and-treat system is in place to collect impacted groundwater. The groundwater is treated on-site at a pretreatment plant located in the mid-canyon area, where metals and organics are extracted. The treated effluent from this process is transferred to the Santa Ana Regional Interceptor (SARI) line where it is discharged under a permit from the Santa Ana Water Project Authority (SAWPA). The SARI line presently transports municipal and industrial wastewater to Orange County, California, where after primary treatment it is discharged directly into the Pacific Ocean.

Figure 1-4 illustrates the overall work area and site zones. The specific well locations included in the passive sampling pilot study are shown in Figure 1-5 for Zone 1B, in Figure 1-6 for Zones 2 and 3, and in Figures 1-7 and 1-8 for Zone 4. DTSC selected the wells

based on the historical monitoring results such that a relatively wide range of concentrations could be evaluated, from wells with relatively greater groundwater impacts (Zone 1B) to wells with low concentrations of volatile organic compounds (VOCs).

1.2 MONITORING PROGRAM OBJECTIVES

A routine groundwater monitoring program has been implemented at the Stringfellow Hazardous Waste Site since August 1984. In coordination with the EPA, DTSC developed a structured groundwater monitoring program to evaluate the Stringfellow Site. The groundwater monitoring workplan was last revised April 2001 (GLA, 2001). The purpose of the program is to collect groundwater quality data to identify of Stringfellow-related groundwater impacts, and to evaluate waste migration, changes in constituent concentrations, and the effectiveness of the groundwater pump-and-treat system.

The purpose of this pilot study is two-fold:

- To evaluate if there is depth-discrete differences in samples collected with a sampling device that employs passive sampling technology, and
- To determine if the average concentrations from the depth-discrete passive sampling devices are comparable with the results from traditional purge-and-sample techniques.

If passive sampling data quality is consistent with results obtained using standard sampling methods, passive sampling methods could be used during future routine monitoring events to reduce labor and/or purge water disposal costs.

1.3 REVIEW OF PASSIVE SAMPLING TECHNOLOGY

Passive groundwater sampling methods have been developed to reduce the need for pre-sampling well purging and subsequent treatment and disposal of purge waters. Passive sampling techniques may be more cost effective than traditional purge-and-sample techniques and can provide depth-discrete information.

The HydrasleeveTM disposable sampler was selected for this study because of its effectiveness, cost, and ease of use. The HydrasleeveTM can be used to test for all compounds, provides a repeatable sampling method, can be used in slow recharge wells, and no purge water disposal is required. The U.S. Geological Survey (USGS) compared results from diffusion bag sampling techniques to traditional purge and sample techniques during an investigation of perchlorate and explosive compounds in groundwater at Camp Edwards in Cape Cod, Massachusetts (LeBlank and Vreblosky, 2008). While the diffusion bag sampling results were similar to the results for pumped samples in the USGS study, the HydrasleeveTM samplers were selected for this study because they can be used for all compounds.

Sampling involves deployment of the HydrasleeveTM devices prior to sampling (for this study, the devices were deployed 7 weeks in advance, but the devices could be deployed a

day before the sampling event). Samples can be collected in less than 15 minutes and equipment decontamination procedures between wells are not needed. Multiple Hydrasleeve™ sampling devices can be deployed in a well to evaluate impacts at vertically discrete zones.

Disadvantages of the Hydrasleeve™ device include a limited sample volume per device, which limits the analytical testing that could be performed on an individual sample. Field parameter testing is limited because the accuracy of some analytes can be affected if a flow-through cell is not employed. In addition, the Hydrasleeve™ sampler can tear if caution is not used when retrieving the sampling device, especially if the device is deployed in a well without casing such as the open borehole wells at the Stringfellow Site. If depth discrete information is required, care must be used when retrieving the sampling device because if the sampler is raised slowly, the check valve may not immediately open and the sample may be collected at a higher location in the water column than was originally intended.

2.0 SAMPLING PROCEDURES

The passive sampling pilot study was conducted between January 28 and March 18, 2008. DTSC selected six wells representative of the Zones 1 through 4 to be sampled with the passive method. The wells were selected based on their locations along the length of the volatile organic compound (VOC) plume, with high concentrations historically measured in samples from Zone 1 wells to concentrations near the regulatory limit to concentrations near the detection limit in wells located at the distal ends of the VOC plume. In each well, the sample depths were selected based on the most permeable water bearing zones identified on the lithologic boring logs (Appendix A).

2.1 SAMPLE LOCATIONS

The locations of the six groundwater monitoring wells selected for the passive sampling pilot study are shown on Figures 1-4 through 1-8. A total of 22 Hydrasleeve™ passive sampling devices were deployed at up to 4 depth-discrete interwell intervals (Table 2-1). Due to small water columns, only three sampling devices were deployed in two of the wells. The vertical intervals for Hydrasleeve™ placement were selected based on the most permeable water-bearing zone identified on the lithologic boring log (Appendix A). For bedrock wells, the samplers were positioned at variable intervals to evaluate changes in contaminant concentrations with depth.

2.2 SAMPLING PROCEDURES



General: The Hydrasleeve™ sampler includes a sleeve to which a weight is attached to the bottom, and the empty device is lowered into a well with a rope. Water pressure keeps the bag collapsed and a check valve located at the top of the sleeve closed, preventing entry of water. Following deployment, the water level in the well is allowed to return to equilibrium prior to sampling. For sampling, the device must be raised faster than one foot per second, which allows the check valve to open and the bag fills with water. The check valve may not open immediately if the Hydrasleeve™ is removed at a slower rate, which would result in sample collection at a more shallow depth than originally intended. The water level change is minimal and there is minimal agitation to the sample. When the bag is full, the check valve closes, disallowing extraneous water from entering the Hydrasleeve™ sampling device. The Hydrasleeve™ can then be

removed from the well, and the water within the sleeve can be transferred to appropriate sample containers (HYDRASleeve, 2008).

Stringfellow Passive Sampling: The sampling procedures listed below were employed during passive sampler deployment and retrieval:

- Hydrasleeve™ passive sampling devices were deployed at depths listed in Table 2-1 and were retrieved 49 to 50 days after deployment.
- During sampler retrieval, field measured pH, conductivity, turbidity, dissolved oxygen, and temperature values were recorded on field sampling sheets (Appendix B).
- All samples were transferred to approved sample containers, and each container was filled completely and immediately capped, labeled, and placed in a cooler with ice.
- Samples were immediately placed in an ice-filled cooler for transport to E.S. Babcock & Sons Laboratory, a California-certified laboratory located in Riverside, California. Samples were kept chilled (at about 4°C) until delivery.
- A trip blank that was provided by the laboratory was added to the chain of custody as a QC sample and added to the cooler.
- A completed Chain-of-Custody form, detailing the sample identification numbers, date and time collected, analyses requested, and other project information accompanied each sample to the laboratory. The Chain-of-Custody forms were signed and dated by all personnel retaining custody of the samples.

2.3 QUALITY ASSURANCE/QUALITY CONTROL SAMPLES

The Quality Assurance/Quality Control (QA/QC) program included collection and analyses of duplicate samples from wells MW-9B (57 feet) and OW-68D1 (53 feet). The duplicate samples were collected, handled, and tested in the same manner as the primary samples. A trip blank sample was scheduled to be submitted and tested for volatile organic compounds; the sampling crew reported that the trip blank was in the cooler (trip blank indicated on chain of custody), but the laboratory reported that no trip blank was received with the sample delivery and was not analyzed.

2.4 LABORATORY TESTING AND DATA VALIDATION

Samples were submitted for testing of volatile organic compounds (EPA Method 8260) and perchlorate [EPA Method 314.0 and ion chromatography tandem mass spectrometry (IC-MS/MS)]. Both test methods for perchlorate were performed because EPA Method 314.0 can be subject to matrix interferences, especially if the sample contains high concentrations of other anions. In addition, p-chlorobenzenesulfonic acid (pCBSA), a known contaminant at the Stringfellow Site, has been identified as an interfering compound near the retention time for perchlorate by EPA Method 314.0, and the IC-MS/MS method provides confirmation regarding the presence of perchlorate.

Certificates of analysis for the samples collected using passive techniques are provided in Appendix C.

Data validation was performed by Laboratory Data Consultants (LDC) under a separate contract to DTSC. A copy of LDC's data validation report is provided in Appendix D.

3.0 MONITORING RESULTS

A description of the local geology of the wells sampled in this study and a summary of the monitoring results are provided in this section.

3.1 PASSIVE SAMPLER DEPLOYMENT AND MONITORING RESULTS

A summary of the analytical results for the passive samples, Spring 2008 routine monitoring event, and Fall 2008 routine monitoring event is presented in Table 3-1. Figures 3-1 through 3-6 summarize well construction, local geology, depth to groundwater measurements, Hydrasleeve™ placement intervals, a summary of the purging record from the April and November 2008 monitoring events (which employed traditional purge and sample techniques), and bar graphs for the analytical results for commonly detected VOCs and perchlorate obtained from the passive sampling and routine monitoring events. A graphical depiction of a comparison between analytical results for perchlorate test methods (EPA Method 314.0 and IC-MS/MS) from passive samples is shown in Figure 3-7, and analytical result comparisons between sampling techniques are shown on Figures 3-8 through 3-14.

Zone 1B Well OC-11B

The local geology at well OC-11B includes about 30 feet of alluvium overlying granodiorite (Figure 3-1). Groundwater at this location occurs in fractured bedrock. The depth to groundwater at the time of deployment of the Hydrasleeve™ samplers was 32.70 feet. Four samplers were deployed within the open-borehole well at depths of 39 feet, 42 feet, 68 feet, and 71 feet. During sampler retrieval, the sampler that was installed at a depth of 39 feet was damaged (presumably by either the bottom of the metal casing or by scraping against the bedrock) and a portion of the water leaked from the bag. As a result, this sample could only be tested for VOCs.

Comparison of the water quality results indicates that there is no apparent vertical stratification of contaminant concentrations in this well (Figure 3-1). While the laboratory diluted the samples that were collected during the routine monitoring events (April and November 2008), which resulted in higher detection limits, the VOC concentrations reported for the routine monitoring events are generally comparable to the four passive samples (Table 3-1). As shown on Table 3-1, the detection limit for the April 2008 routine samples were higher than the concentrations reported for the passive samples and the November 2008 routine samples. For the passive samples, no perchlorate was detected in any of the tests that employed EPA Method 314.0 because of the high detection limits; perchlorate was measured in the samples that were tested using IC-MS/MS, which had a lower detection limit. For the routine samples, the laboratory reported sample matrix interference using EPA Method 314.0, and the reported concentration (1,200 micrograms per liter [$\mu\text{g/L}$]) may be elevated due to the interference. For the IC-MS/MS testing, the perchlorate concentration reported for the November 2008 sampling event was equal to the average concentration from the passive samples (160 $\mu\text{g/L}$).

Zone 1B Well OW-68D1

Well OW-68D1 is screened in fractured bedrock. Owing to a small water column, the passive sampling devices were installed at only three intervals (50, 53, and 56 feet). Upon retrieval of the sampling devices, only the lower two contained sufficient water for analytical testing. As shown on Figure 3-2 and Table 3-1, the VOC concentrations for each of the passive sampling intervals are similar to the routine sample except for low concentrations of gasoline compounds that were detected in the November 2008 routine sample. Perchlorate was identified using the IC-MS/MS method in both of the passive samples. No perchlorate was identified in any of the samples using EPA Method 314.0 because the samples required dilution, which resulted in higher detection limits. The perchlorate concentration from IC-MS/MS testing reported for the November 2008 sampling event (150 µg/L) was 25 percent higher than the average passive sample results (120 µg/L).

Zone 2 Well MW-9B

Zone 2 Well MW-9B was constructed in sand and gravelly sand (Figure 3-3). Four sampling devices were deployed at depths ranging from 57 to 81 feet within this well. The analytical results from the passive samplers indicated no apparent vertical stratification for VOC or perchlorate concentrations (Figure 3-3). Perchlorate and trichloroethene (TCE) concentrations for the sample collected during the routine sampling events were similar to those measured in the passive samples (within 15 percent). However, low concentrations of chloroform [5.0 to 6.0 micrograms per liter (µg/L)] were reported for each of the passive samples, but no chloroform was detected in the samples from the routine monitoring events. It should be noted that all six of the samples were diluted because of the relatively high TCE concentrations, and the reported chloroform values for the samples that were collected using passive techniques were slightly above the method detection limit (MDL; 4.6 µg/L).

Zone 3 Well LEO-11A

Well LEO-11A is screened in silty sand and silty sand with gravel (Figure 3-4). While three Hydrasleeve™ sampling devices were deployed in this well at depths ranging from 55 to 61 feet, insufficient water was present for sampling of the upper device. TCE, chloroform, and perchlorate were detected in both passive samples at similar concentrations, indicating no vertical stratification. In addition, the analytical results for the samples collected using purge and sample techniques were generally similar to the average concentrations of the passive samples (within 20 percent), although the November 2008 TCE concentration was 24 percent higher than the average TCE concentration reported for the passive sampling devices.

Zone 4 Well CTS-OW3

The screen interval for well CTS-OW3 was constructed across interbedded sand and silty sand (Figure 3-5). Four Hydrasleeve™ sampling devices were deployed within two of the screened sand horizons. Perchlorate, chloroform, and TCE were detected in each of the samples; the reported concentrations of each of these compounds were highest in the deepest sample (by factors of about 1.5 to 2), suggesting some vertical stratification. All three compounds were also detected in the samples that were collected using purge and sample techniques. For perchlorate monitoring results, the IC-MS/MS testing of the November 2008 pumping sample was within 5 percent of the average concentration reported for the passive samples. However, for EPA Method 314.0 testing, the pumped result (11 µg/L) was less than half of the average from the passive samples (28.5 µg/L). The TCE concentrations for both of the pumped samples were less than half of the average concentration reported for the passive samples (Table 3-1). It is also noted that the TCE concentrations reported for each of the Hydrasleeve™ samples was higher than the regulatory limit (5 µg/L), while the TCE concentrations for both of the pumped samples were below the regulatory limit.

Zone 4 Well FC-1020A

Well FC-1020A is screened across silty sand from 15 feet to 55 feet, and in decomposed granitic bedrock from 55 to 60 feet (Figure 3-6). Four passive sampling devices were deployed at 5-foot intervals at depths ranging from 35 to 50 feet. Perchlorate and TCE were detected in all samples (Table 3-1). The analytical results for the passive samplers suggested no apparent vertical stratification of contaminant concentrations. The TCE and perchlorate concentrations reported for the Spring 2008 routine monitoring event were within 25 percent of the average concentrations reported for the passive samples. For the November 2008 routine sample, the TCE concentration was within 25 percent of the average concentration reported for the passive samples, but perchlorate was 35 percent higher than for the average from the passive samples.

3.2 PERCHLORATE TEST METHOD COMPARISON

Samples collected from the passive sampling devices were tested for perchlorate using EPA Method 314.0 and IC-MS/MS methods, while only EPA Method 314.0 was employed for the Spring 2008 routine samples and only IC-MS/MS test methods were employed for the Fall 2008 perchlorate testing. To compare the analytical test methods for a given sample, the perchlorate results from the passive samples from wells MW-9B, LEO-11A, CTS-OW3, and FC-1020A were plotted on a single graph (Figure 3-7). Wells OC-11B and OW-68D1 were omitted because the samples were diluted for the EPA Method 314.0 testing, which resulted in elevated detection limits.

On Figure 3-7, equal concentrations for both test methods would plot on the 1:1 diagonal line. As shown, the data points plot close to the 1:1 diagonal line, indicating that the perchlorate results from EPA Method 314.0 are comparable to the results from IC-

MS/MS. The good agreement was observed at a wide variation in concentration levels (from 16 µg/L to nearly 500 µg/L).

3.3 SAMPLING METHOD COMPARISON

The reported concentrations for the pumped and passive samples for select contaminants of concern [perchlorate by EPA Method 314.0, perchlorate by IC-MS/MS, tetrachloroethene (PCE), trichloroethene (TCE), and chloroform] are compared graphically on Figures 3-8 through 3-14. On these figures, only the Spring 2008 data are plotted against the passive sampling results to minimize temporal variations. As described above, if the passive and pumped sampling methods produced samples with equal concentrations, all of the points on the graphs would fall on the respective 1:1 diagonal line.

The finding that most of the points fell close to the 1:1 diagonal lines indicates that the analytical results from the Hydrasleeve™ samples were comparable to the samples that were collected following the purge-and-sample collection techniques. The results from well CTS-OW3 showed the greatest variance from the 1:1 diagonal line; the results from this well also showed the most variance for the depth-discrete passive samples, with the highest concentrations reported for the deepest sample.

While 35 to 42 days elapsed between collection of the Hydrasleeve™ samples and the Spring 2008 samples, time-series charts (Appendix E) suggest that the concentrations for both sample sets correlate with historical analytical results. The concentration differences between the two sampling methods are not significant for samples with high concentrations, but are significant for samples with concentrations near the regulatory limits. For example, at well CTS-OW3, the TCE concentrations for the Hydrasleeve™ samples exceeded the regulatory limit but were below the regulatory limit for each of the pumped samples. Additional sampling of wells with VOC concentrations near regulatory limits should be performed to further evaluate the variation in VOC concentrations for the two sampling methods.

4.0 CONCLUSIONS AND RECOMMENDATIONS

4.1 CONCLUSIONS

Based on the results of the sampling program described in this report, the following conclusions were developed:

- Passive Hydrasleeve™ sampling devices were deployed in six wells and allowed to equilibrate for 49 to 50 days.
- To evaluate possible variation in concentrations with respect to variations in permeability or preferential contaminant pathways due to variation in aquifer materials, multiple Hydrasleeve™ sampling devices were deployed in each well. Three passive samplers were deployed at vertically discrete intervals in two wells, and four samplers were deployed at vertically discrete intervals in four wells. The depth of deployment was based on permeable zones as determined from boring logs and the available saturated zone within a well at the time of deployment.
- The passive samples were tested for perchlorate by EPA Method 314.0 and IC-MS/MS, and VOCs by EPA Method 8260.
- Analytical results from one well (CTS-OW3) indicated some vertical stratification for perchlorate, with the highest concentrations reported in the deepest sample. No apparent vertical stratification was noted for perchlorate in the other wells, nor for VOCs in any of the wells.
- The samples from two wells (OC-11B and OW-68D1) required dilution before testing by EPA Method 314.0 because of matrix interference, which resulted in detection limits that were higher than the analytical results provided by the IC-MS/MS test method. Based on the average result from the EPA Method 314.0 testing and IC-MS/MS testing for the other 14 passive samples, the reported analytical result for a specific test method was within 5 percent of the average concentration for 8 samples, within 5 to 8 percent for 4 samples, and within 11 percent for the remaining 2 samples.
- For EPA Method 314.0 testing, the average perchlorate concentrations reported for the passive samples differed from the results from the Spring 2008 sampling by less than 13 percent for 3 samples. However, the concentrations for CTW-OW3 differed by 60 percent due to the relatively high concentrations reported for the deepest passive sample.
- The routine sampling events were performed one month (Spring 2008) and eight months (Fall 2008) following the passive sampling event.
- Differences between IC-MS/MS analytical results for the average concentration from passive samples and the concentration from the Fall 2008 sampling event ranged from 0 to 15 percent.
- For detected VOCs, the analytical results for the passive samples were generally within 10 percent of the results for samples collected using traditional purge and sample techniques. A notable exception includes TCE concentrations in samples from well CTS-OW3, where Hydrasleeve™ samples contained TCE concentrations at levels above the regulatory limits, while TCE concentrations in

samples collected using traditional purge-and-sample techniques were below regulatory limits.

- The differences in concentrations reported for the pumped and passive samples might be partly explained by the elapsed time between sampling events (1 to 8 months).

In summary, it is concluded that the HydrasleeveTM passive sampling devices provide similar results as samples collected using traditional purge and sample methods.

4.2 RECOMMENDATIONS

Based on the conclusions described above and the information obtained during sample collection, the following recommendations have been developed:

- Little variability was noted for depth-discrete samples in a single well. Therefore, it appears to be sufficient to collect one sample in the middle of the saturated screen interval, although the local geology should be evaluated in wells that span several geologic units (alluvium and bedrock, for example).
- The sample volume provided by the passive sampling devices (less than 0.7 liters for a 2-inch device; approximate 1.6 liters for a 4-inch device) may limit the analytical suite, but this limitation could be overcome by deploying multiple HydrasleeveTM devices in a single well if an expanded analytical suite is planned.
- Retrieval of HydrasleeveTM sampling devices from open borehole wells should be performed with caution owing to the potential for tearing of the device on rough bedrock walls or the bottom of the protective surface casing.
- If additional comparisons between sampling methods are performed, the temporal difference between the two samples should be minimized. Optimally, the passive samples should be collected immediately prior to purging of the well for samples collected using traditional purge-and-sample techniques.
- Additional testing of wells with concentrations near regulatory limits should be performed to support selection of optimal sampling and analytical methods.

5.0 REFERENCES

GeoLogic Associates, 2001, "Work Plan, Groundwater Monitoring Program, Stringfellow Hazardous Waste Site," prepared for California Department of Toxic Substances Control, Stringfellow Branch, April.

HYDRASleeve, 2008, No-Purge Groundwater Sampler, <http://www.nopurgesampling.com/>.

LeBlanc, D.R., and Vroblesky, D.A. 2008, Comparison of pumped and diffusion sampling methods to monitor concentrations of perchlorate and explosive compounds in ground water, Camp Edwards, Cape Cod, Massachusetts, 200-05: U.S. Geological Survey Scientific Investigations Report 2008-5109, 16 p.

U.S. Environmental Protection Agency, 1989, "Test Methods for Evaluation Solid Waste," U.S. EPA SW-846.

TABLES

TABLE 2-1
WELL LOCATIONS AND DEPTH OF HYDRASLEEVE™ DEPLOYMENT
PASSIVE SAMPLING PILOT STUDY REPORT
STRINGFELLOW HAZARDOUS WASTE SITE

Zone 1A	Zone 1B	Zone 2	Zone 3	Zone 4	
OC-11B	OW-68D1	MW-9B	LEO-11A	CTS-OW3	FC-1020A
39	50	57	55	55	35
42	53	65	58	58	40
68	56	73	61	75	45
71	-	81	-	78	50

Note: Depths are listed in feet below top of well casing.

TABLE 3-1
SUMMARY OF ANALYTICAL RESULTS
PASSIVE SAMPLING PILOT STUDY REPORT
STRINGFELLOW HAZARDOUS WASTE SITE

Well Name	Zone	Sample Type	Depth Interval of Sample (feet below TOC)	Date Passive Sampler Deployed	Date Sample Collected	Days Passive Sampler in Well	Days Between Collection of Passive and Pumped Samples	Depth to Groundwater (feet below TOC)	Perchlorate IC-MS/MS (µg/L)	Perchlorate 314.0 (µg/L)	1,2-DCB (µg/L)	1,3-DCB (µg/L)	1,4-DCB (µg/L)	Chlorobenzene (µg/L)	Chloroform (µg/L)	MTBE (µg/L)	PCE (µg/L)	TCE (µg/L)	Acetone (µg/L)	cis-1,2-DCE (µg/L)	Methylene Chloride (µg/L)	1,2,4-TMB (µg/L)	Toluene (µg/L)	MIBK (µg/L)	Ethylbenzene (µg/L)	Xylenes (m+p) (µg/L)	Xylenes (ortho) (µg/L)	
OC-11B	1B	Passive	39	1/28/2008	3/17/2008	49	-	32.7	not tested	not tested	1000	35j	260	170	380	<43	110	2400	320j	110	400	<9.3	<22	<95	<26	<36	<41	
	1B	Passive	42	1/28/2008	3/17/2008	49	-	32.7	150	<230	1300	37j	330	220	470	<43	110	2500	290j	75	520	10j	27j	<95	<26	<36	<41	
	1B	Passive	68	1/28/2008	3/17/2008	49	-	32.7	160	<230	1200	42j	300	200	430	<43	110	2300	330j	92	470	<9.3	26j	<95	<26	<36	<41	
	1B	Passive	71	1/28/2008	3/17/2008	49	-	32.7	170	<230	1200	38j	310	190	460	<43	120	2700	220j	82	540	<9.3	28j	98j	<26	<36	<41	
	1B	Passive	Average	NA	NA	NA	-	-	160	NC	1175	38j	300	195	435	NC	112.5	2475	290j	90	483	<9.3	23	<95	<26	<36	<41	
	1B	Routine	NA	NA	4/21/2008	-	35	33.72	NA	1200*	1100	<60	320	210	480	<170	110	2500	<2000	<74	560	<37	<89	<380	<110	<160	<160	
OW-68D1	1B	Passive	50	1/28/2008	3/18/2008	50	-	49.6	DRY	DRY	DRY	DRY	DRY	DRY	DRY	DRY	DRY	DRY	DRY	DRY	DRY	DRY	DRY	DRY	DRY	DRY	DRY	DRY
	1B	Passive	53	1/28/2008	3/18/2008	50	-	49.6	120	<1200*	6000	190j	1600	1500	1100	<170	470	6300	3000	120j	870	50j	110j	420	<110	<140	<160	
	1B	Passive	56	1/28/2008	3/18/2008	50	-	49.6	120	<2300*	5300	160j	1400	1500	980	<170	410	6200	2800	110j	830	<37	100j	470	<110	<140	<160	
	1B	Passive	Average	NA	NA	NA	-	-	120	NC	5650	175	1500	1500	1040	NC	440	6250	2900	115j	850	<37	105j	445	<110	<140	<160	
	1B	Routine	NA	NA	4/24/2008	-	37	51.3	NA	<460*	5400	160j	1600	1500	1000	<170	440	7100	2600	130j	870	<37	105j	445	<110	<140	<160	
	1B	Routine	NA	NA	11/26/2008	-	253	48.65	150	NA	5900	190	1600	2200	1300	<43	430	6700	2400	100	960	21j	100	430j	110	94	41j	
MW-9B	2	Passive	57	1/28/2008	3/17/2008	49	-	47.4	390	440	<2.0	<1.5	<0.72	<2.3	5.6	<4.3	<1.7	120	27j	<1.8	<5.0	<0.93	<2.2	<9.5	<2.6	<3.6	<4.1	
	2	Passive	65	1/28/2008	3/17/2008	49	-	47.4	410	420	<2.0	<1.5	<0.72	<2.3	5	<4.3	<1.7	130	33j	<1.8	<5.0	<0.93	<2.2	<9.5	<2.6	<3.6	<4.1	
	2	Passive	73	1/28/2008	3/17/2008	49	-	47.4	410	460	<2.0	<1.5	<0.72	<2.3	5.2	<4.3	<1.7	140	28j	<1.8	<5.0	<0.93	<2.2	<9.5	<2.6	<3.6	<4.1	
	2	Passive	81	1/28/2008	3/17/2008	49	-	47.4	410	470	<2.0	<1.5	<0.72	<2.3	6	<4.3	<1.7	140	30j	<1.8	<5.0	<0.93	<2.2	<9.5	<2.6	<3.6	<4.1	
	2	Passive	Average	NA	NA	NA	-	-	405	447.5	NC	NC	NC	NC	5.5	NC	NC	132.5	30j	NC	NC	NC	NC	NC	NC	NC	NC	
	2	Routine	NA	-	4/28/2008	-	42	49.61	NA	410	<2.0	<1.5	<0.72	<2.3	<4.6	<4.3	<1.7	130	<5.0	<1.8	<5.0	<0.93	<2.2	<9.5	<2.6	<3.6	<4.1	
LEO-11A	3	Passive	55	1/28/2008	3/17/2008	49	-	53.71	DRY	DRY	DRY	DRY	DRY	DRY	DRY	DRY	DRY	DRY	DRY	DRY	DRY	DRY	DRY	DRY	DRY	DRY	DRY	DRY
	3	Passive	58	1/28/2008	3/17/2008	49	-	53.71	120	150	<0.2	<0.15	<0.072	<0.23	2.4	<0.43	<0.17	36	1.3j	<0.18	<0.50	<0.093	<0.22	<0.95	<0.26	<0.36	<0.41	
	3	Passive	61	1/28/2008	3/17/2008	49	-	53.71	120	140	<0.2	<0.15	<0.072	<0.23	2.7	<0.43	<0.17	38	1.5j	<0.18	<0.50	<0.093	<0.22	<0.95	<0.26	<0.36	<0.41	
	3	Passive	Average	NA	NA	NA	-	-	120	145	NC	NC	NC	NC	2.6	NC	NC	37	1.4j	NC	NC	NC	NC	NC	NC	NC	NC	
	3	Routine	NA	-	4/21/2008	-	35	55.09	NA	120	<0.2	<0.15	<0.072	<0.23	2.3	<0.43	<0.17	36	<5.0	<0.18	<0.50	<0.093	<0.22	<0.95	<0.26	<0.36	<0.41	
	3	Routine	NA	-	11/21/2008	-	249	54.69	140	NA	<0.2	<0.15	<0.072	<0.23	3	<0.43	<0.17	46	<5.0	<0.18	<0.50	<0.093	<0.22	<0.95	<0.26	<0.36	<0.41	
CTS-OW3	4	Passive	55	1/28/2008	3/17/2008	49	-	26.05	25	26	<0.2	<0.15	<0.072	<0.23	0.82	<0.43	<0.17	8.1	1.7j	<0.18	<0.50	<0.093	<0.22	<0.95	<0.26	<0.36	<0.41	
	4	Passive	58	1/28/2008	3/17/2008	49	-	26.05	22	23	<0.2	<0.15	<0.072	<0.23	0.68	<0.43	<0.17	7	2.4j	<0.18	<0.50	<0.093	<0.22	<0.95	<0.26	<0.36	<0.41	
	4	Passive	75	1/28/2008	3/17/2008	49	-	26.05	20	25	<0.2	<0.15	<0.072	<0.23	0.61	<0.43	<0.17	8.2	2.6j	<0.18	<0.50	<0.093	<0.22	<0.95	<0.26	<0.36	<0.41	
	4	Passive	78	1/28/2008	3/17/2008	49	-	26.05	36	40	<0.2	<0.15	<0.072	<0.23	1.3	<0.43	<0.17	16	<1.2	<0.18	<0.50	<0.093	<0.22	<0.95	<0.26	<0.36	<0.41	
	4	Passive	Average	NA	NA	-	-	-	25.8	28.5	NC	NC	NC	NC	0.9	NC	NC	9.8	1.8j	NC	NC	NC	NC	NC	NC	NC	NC	
	4	Routine	NA	-	4/21/2008	-	35	25.47	NA	11	<0.2	<0.15	<0.072	<0.23	0.53	<0.43	<0.17	3.7	5.3	<0.18	<0.50	<0.093	<0.22	<0.95	<0.26	<0.36	<0.41	
FC-1020A	4	Passive	35	1/28/2008	3/17/2008	49	-	12.31	17	16	<0.2	<0.2	<0.072	<0.23	<0.46	<0.43	<0.17	0.67	1.6j	<0.18	<0.50	<0.093	<0.22	<0.95	<0.26	<0.36	<0.41	
	4	Passive	40	1/28/2008	3/17/2008	49	-	12.31	16	17	<0.2	<0.2	<0.072	<0.23	<0.46	<0.43	<0.17	0.62	1.5j	<0.18	<0.50	<0.093	<0.22	<0.95	<0.26	<0.36	<0.41	
	4	Passive	45	1/28/2008	3/17/2008	49	-	12.31	17	16	<0.2	<0.2	<0.072	<0.23	<0.46	<0.43	<0.17	0.57	<1.2	<0.18	<0.50	<0.093	<0.22	<0.95	<0.26	<0.36	<0.41	
	4	Passive	50	1/28/2008	3/17/2008	49	-	12.31	18	18	<0.2	<0.2	<0.072	<0.23	<0.46	<0.43	<0.17	0.58	1.5j	<0.18	<0.50	<0.093	<0.22	<0.95	<0.26	<0.36	<0.41	
	4	Passive	Average	NA	NA	-	-	-	17	16.8	NC	NC	NC	NC	NC	NC	NC	0.61	1.3j	NC	NC	NC	NC	NC	NC	NC	NC	
	4	Routine	NA	-	4/23/2008	-	37	14.74	NA	13	<0.2	<0.2	<0.072	<0.23	<0.46	<0.43	<0.17	0.72	5.2	<0.18	<0.50	<0.093	<0.22	<0.95	<0.26	<0.36	<0.41	

Notes: * - Indicates lab reporting limit elevated due to sample matrix.
j - Indicates estimated trace concentration (between MDL and PQL).
NA - Not applicable.
NC - Not calculated.

FIGURES

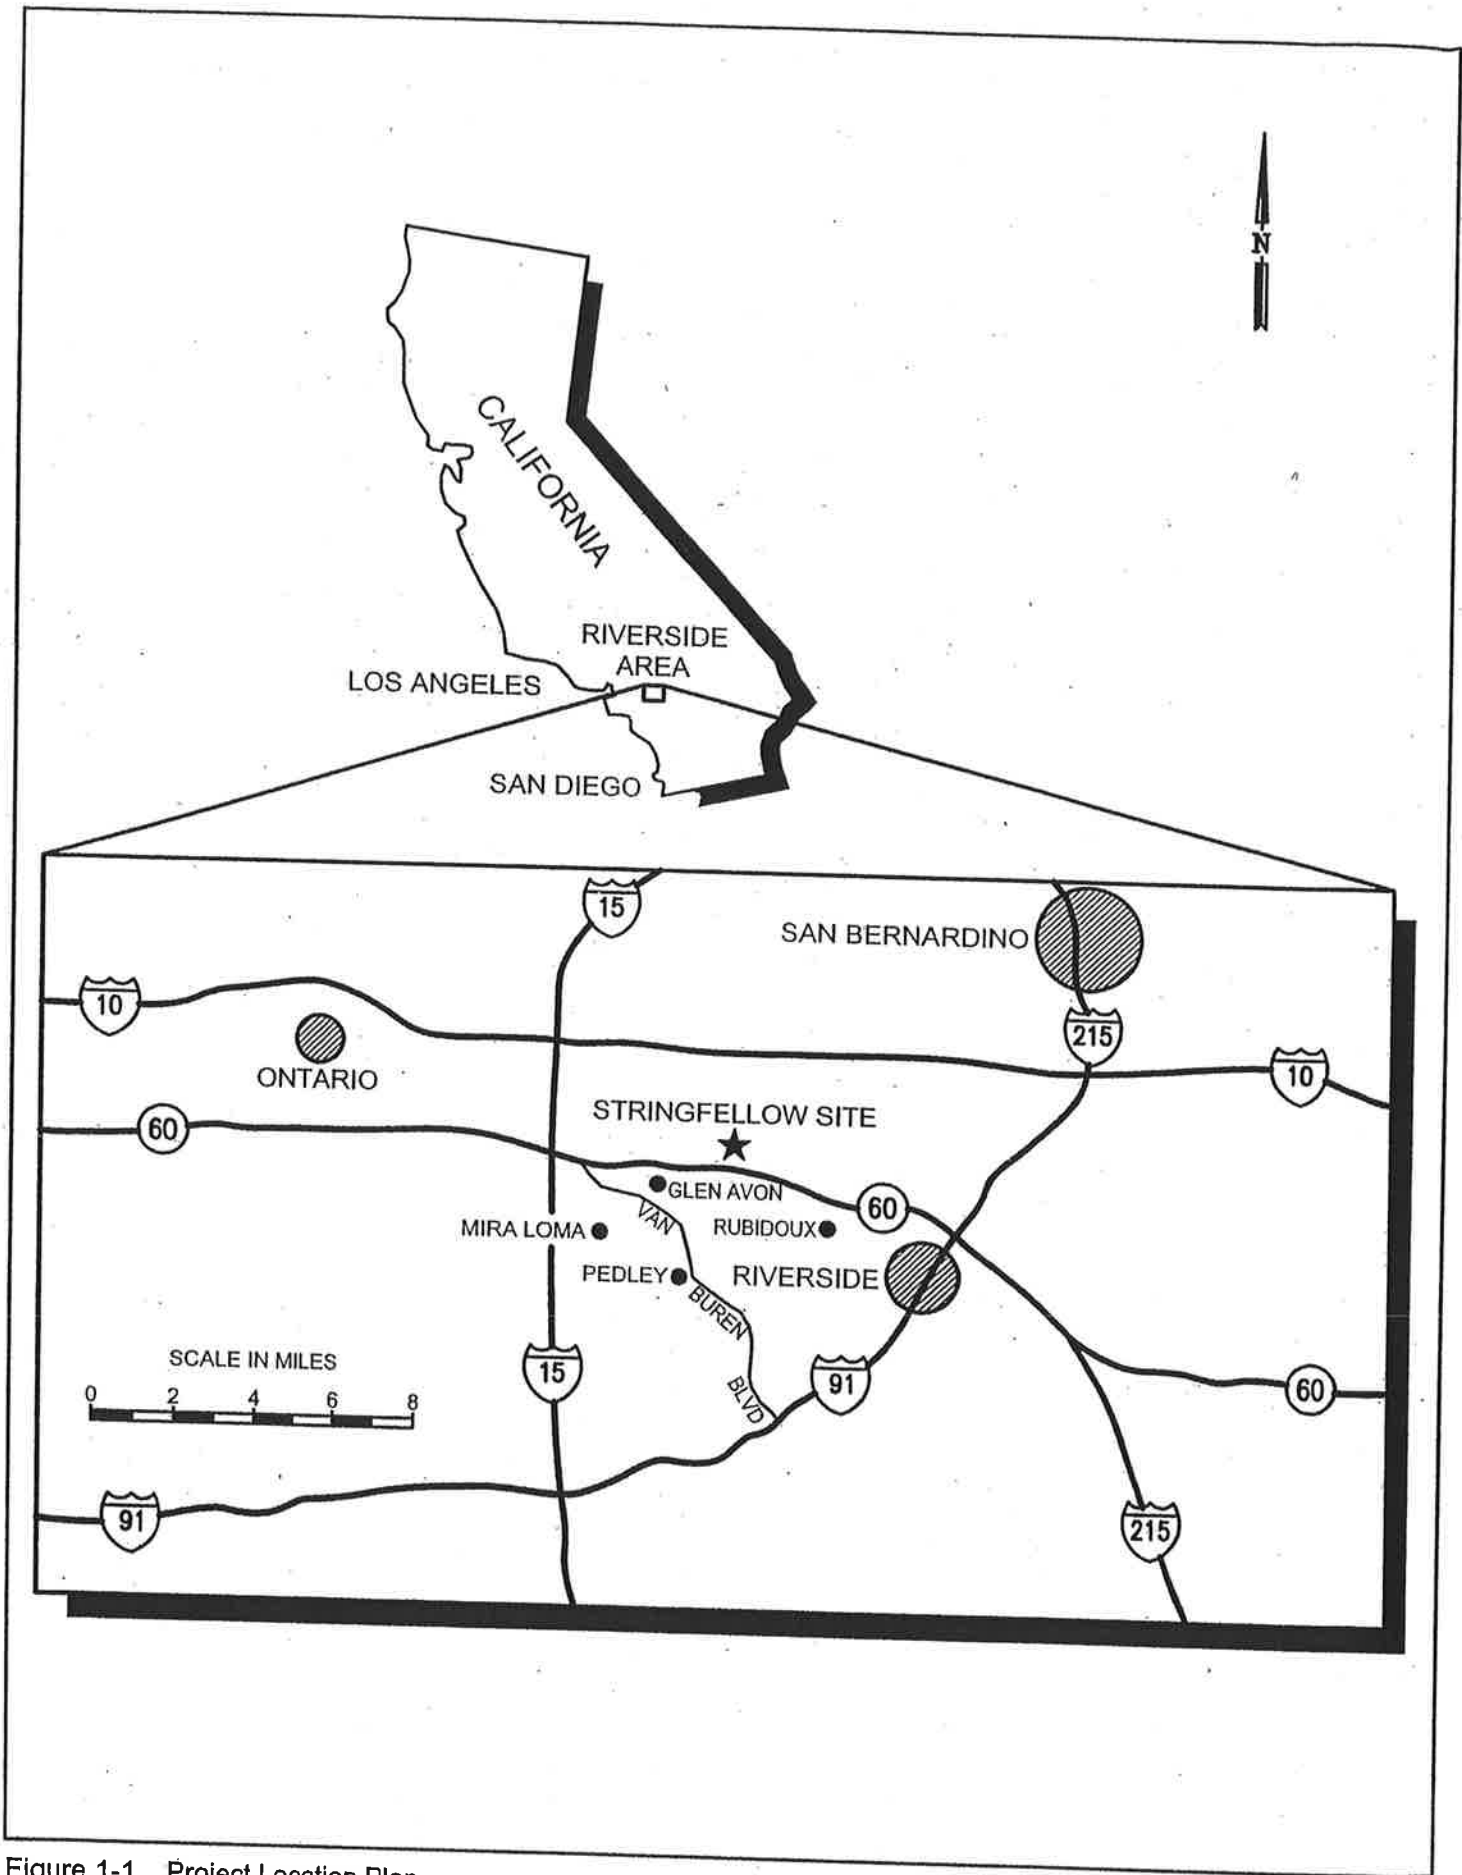


Figure 1-1 Project Location Plan

SAN BERNARDINO COUNTY



RIVERSIDE COUNTY

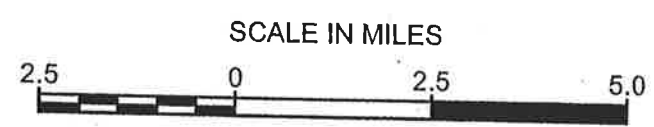


Figure 1-2 Site Vicinity

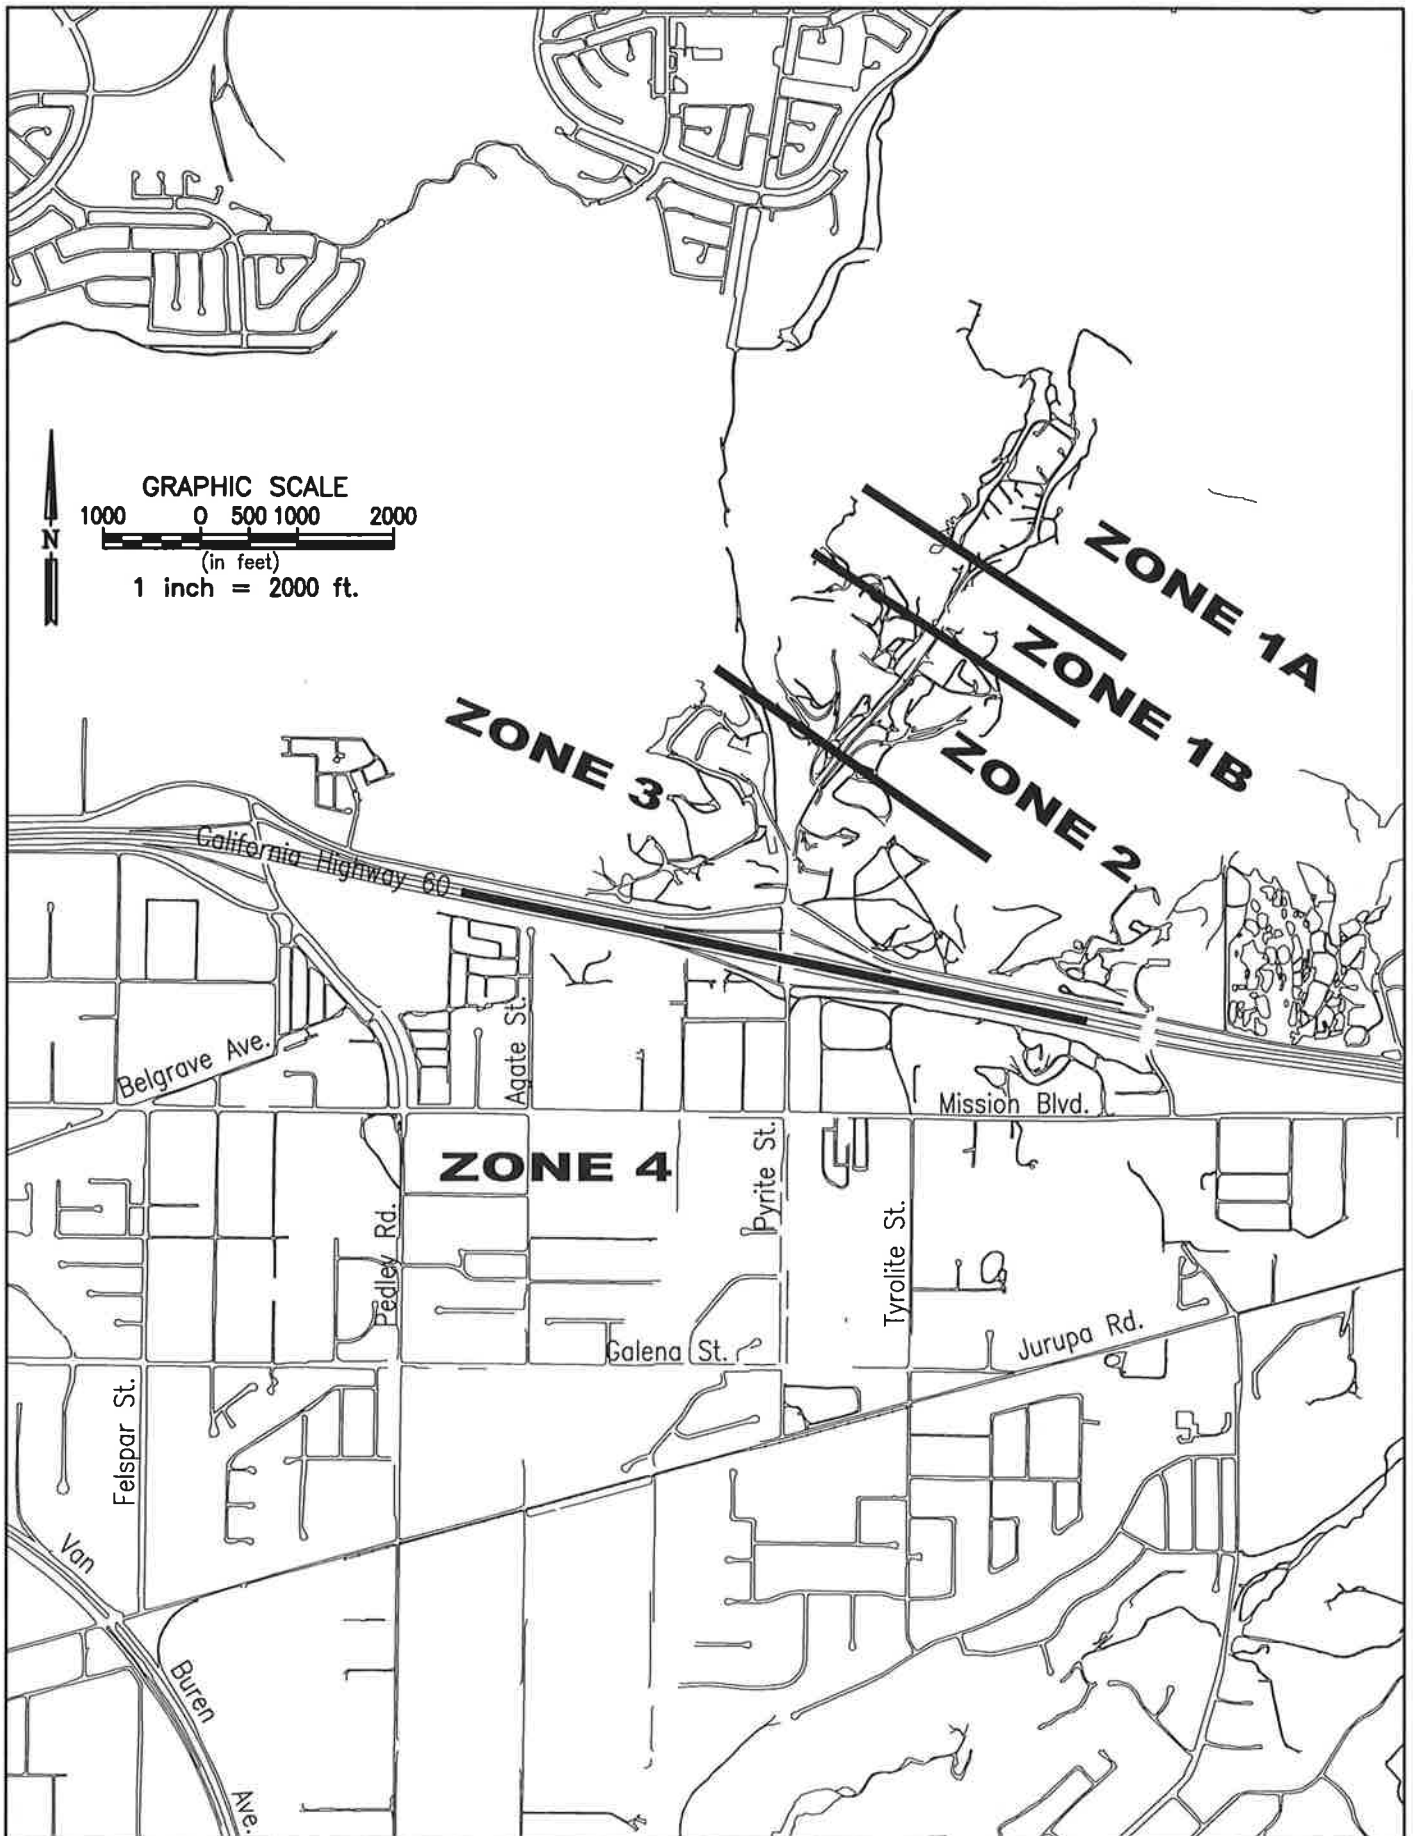


Figure 1-3 Location of Zones 1 - 4

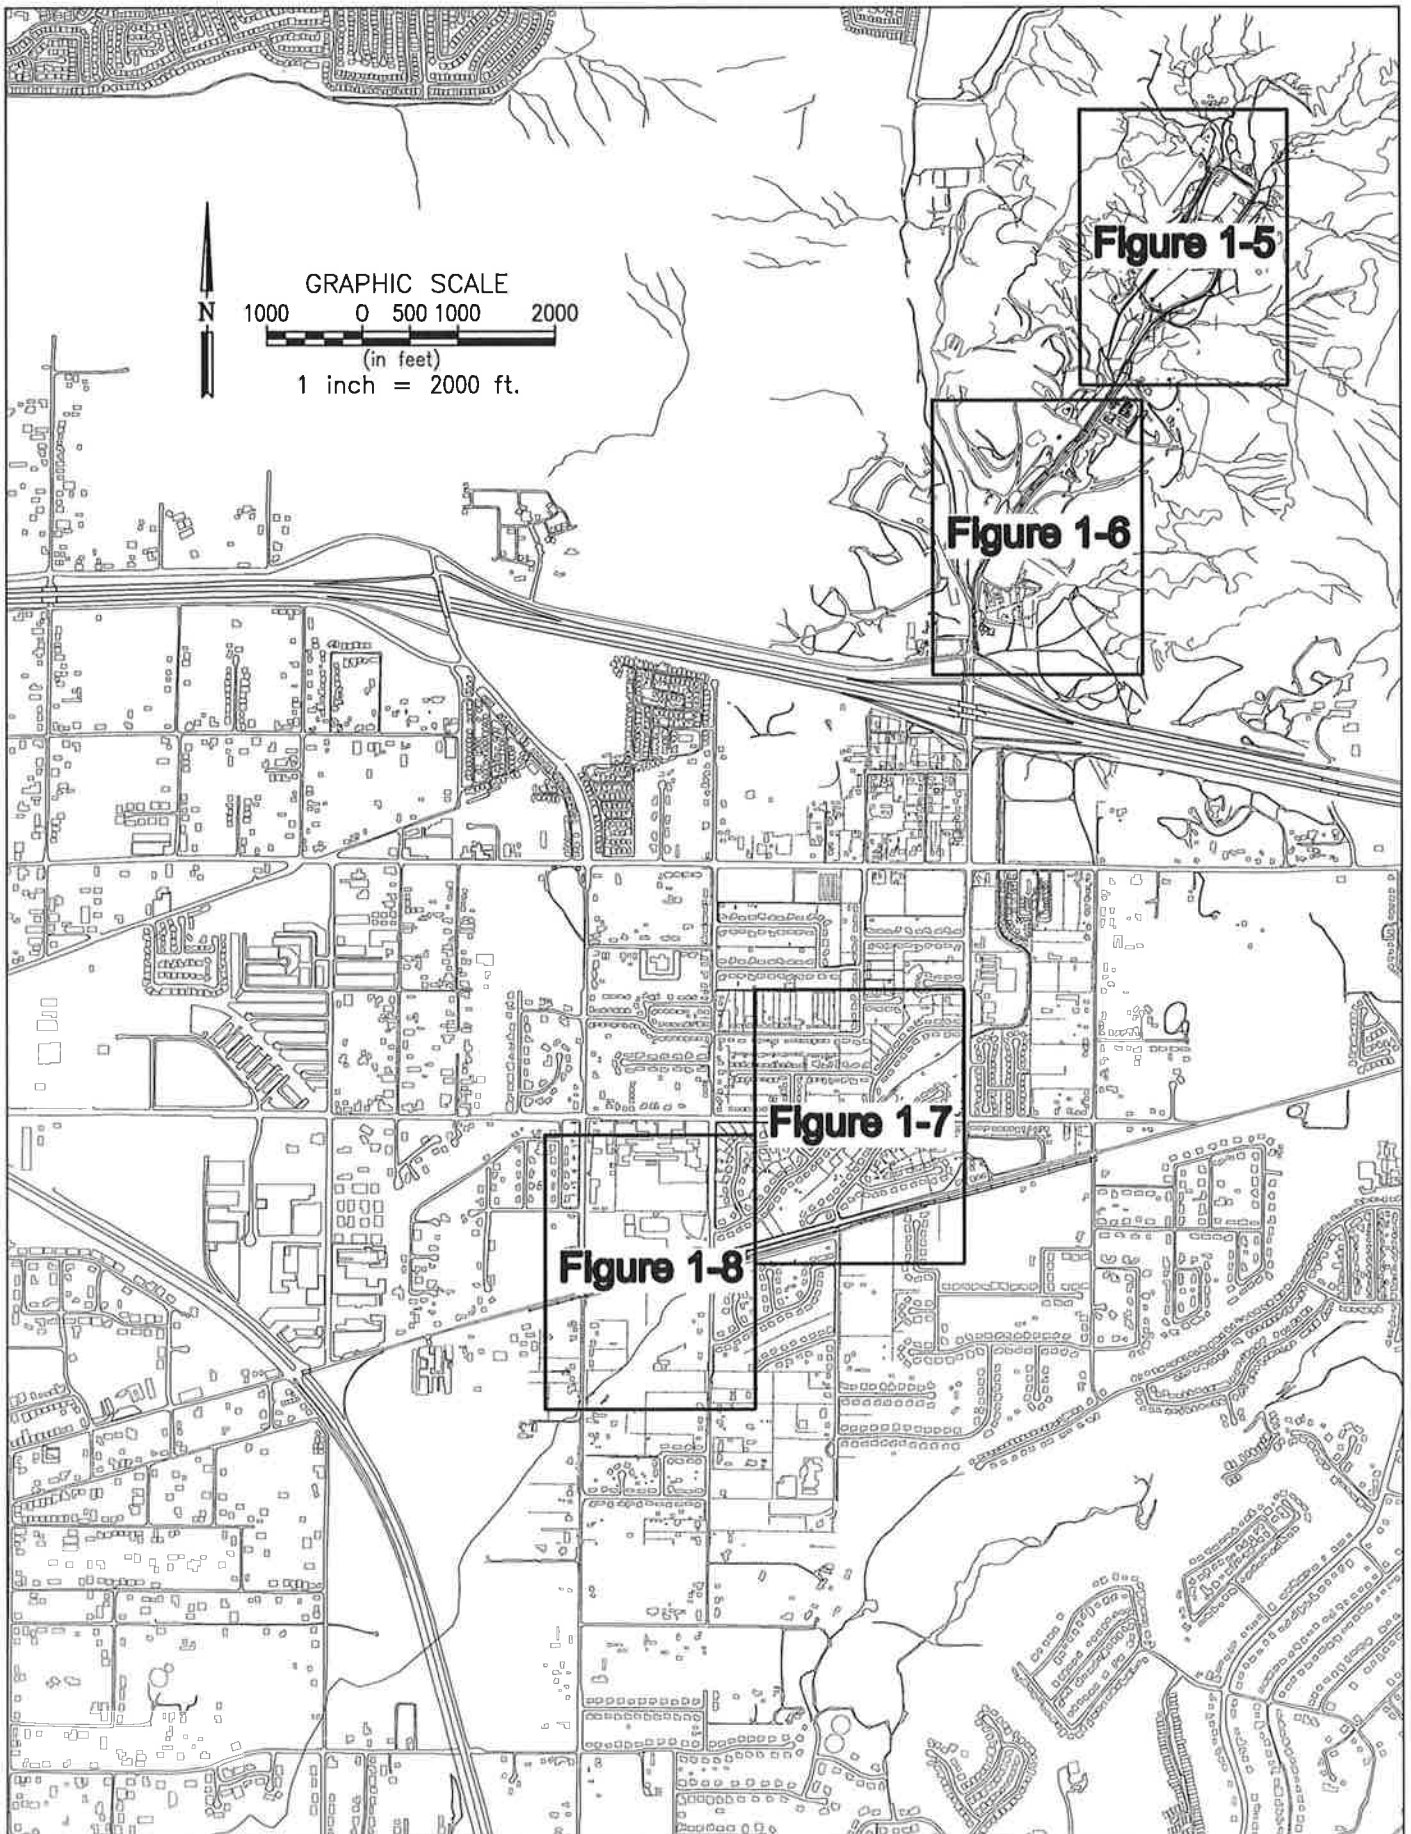


Figure 1-4 Index Map - Passive Sampler Pilot Study, May 2008

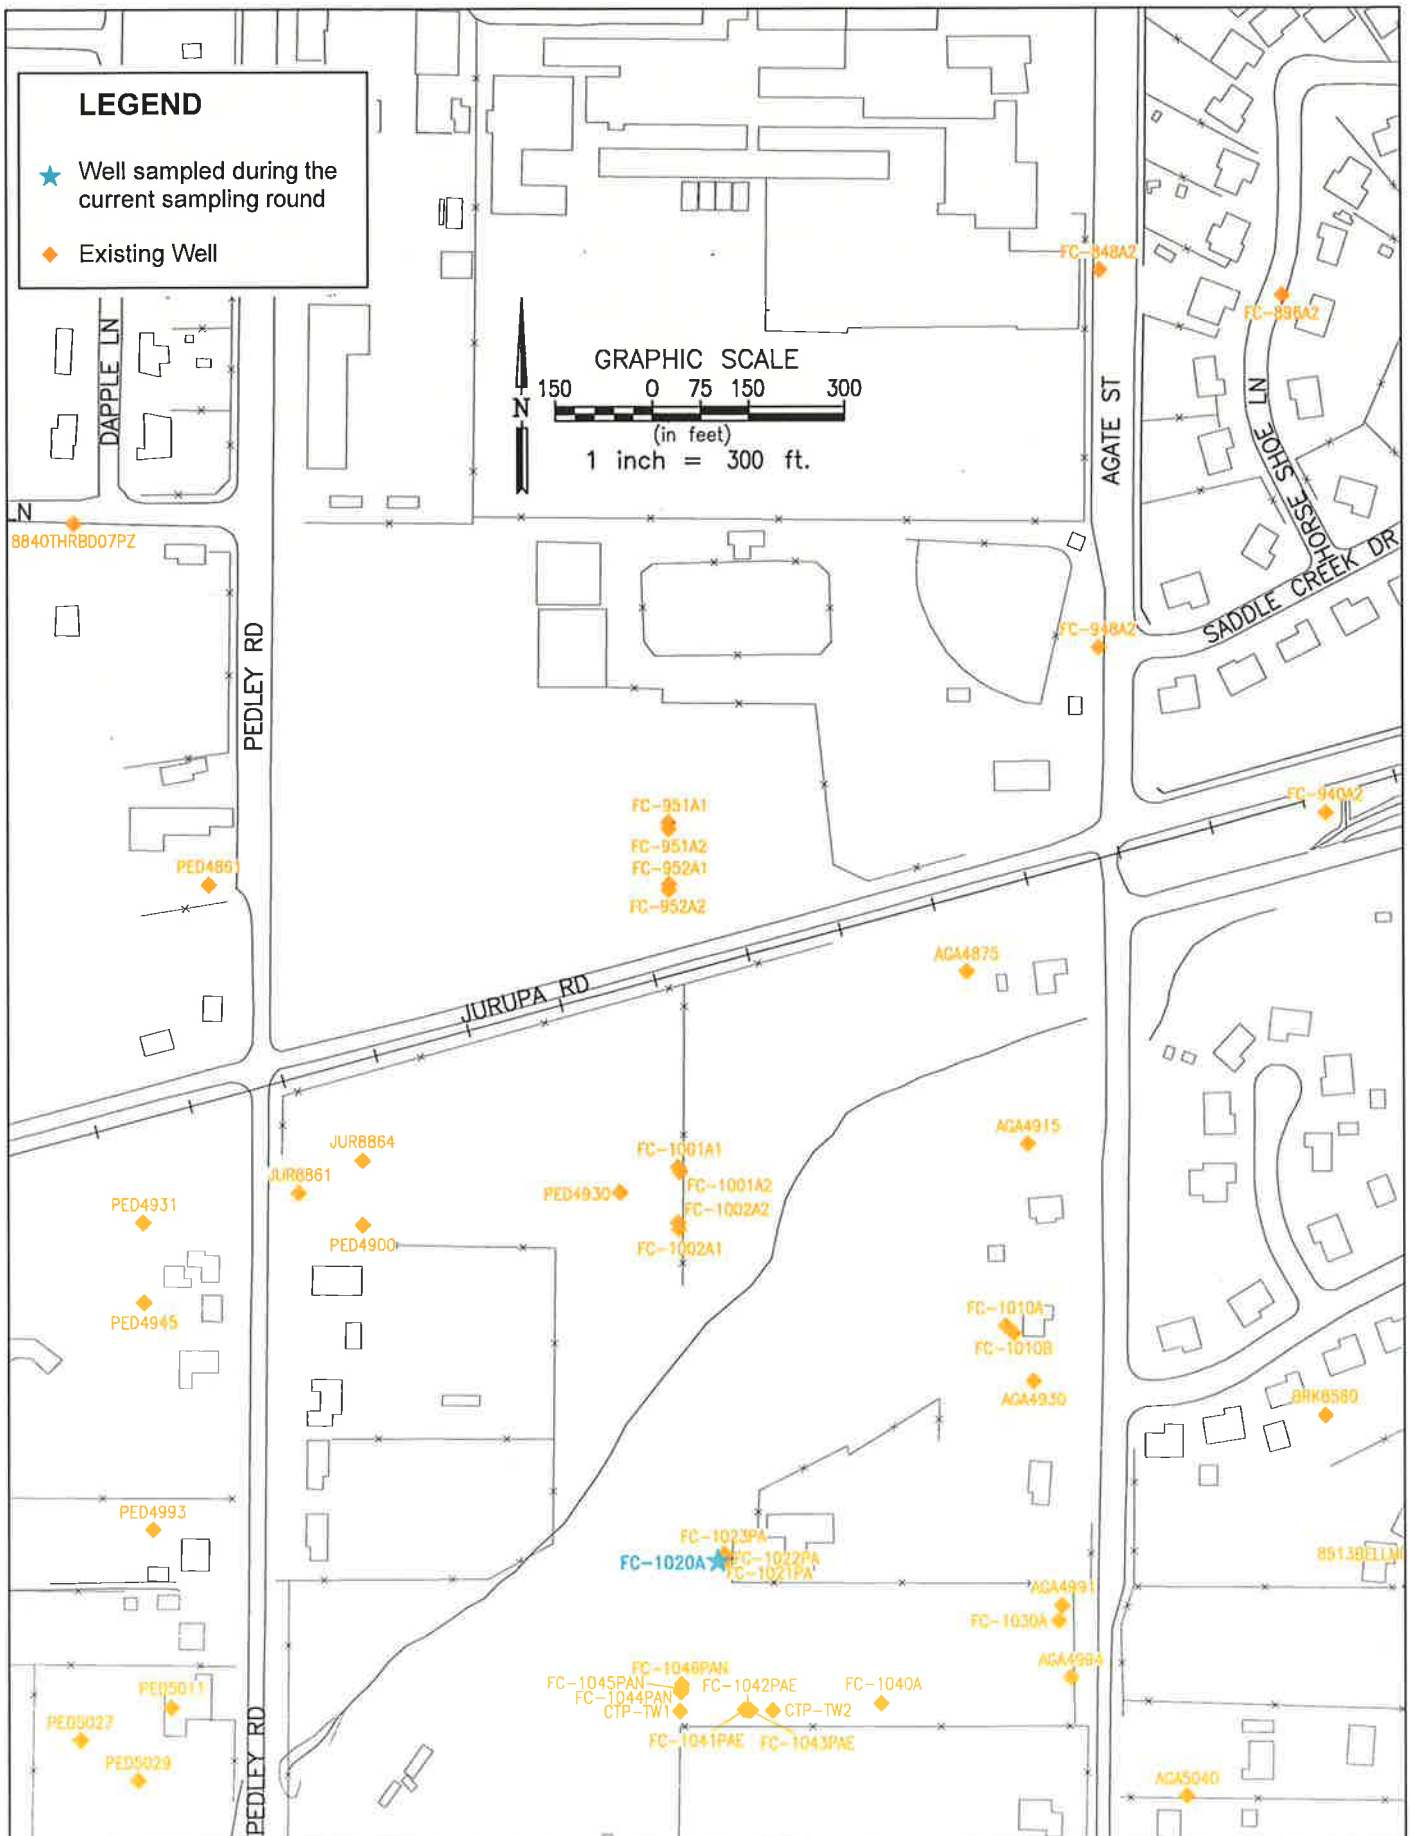


Figure 1-8 Downgradient Zone 4 Well Location Map - Passive Sampler Pilot Study, May 2008

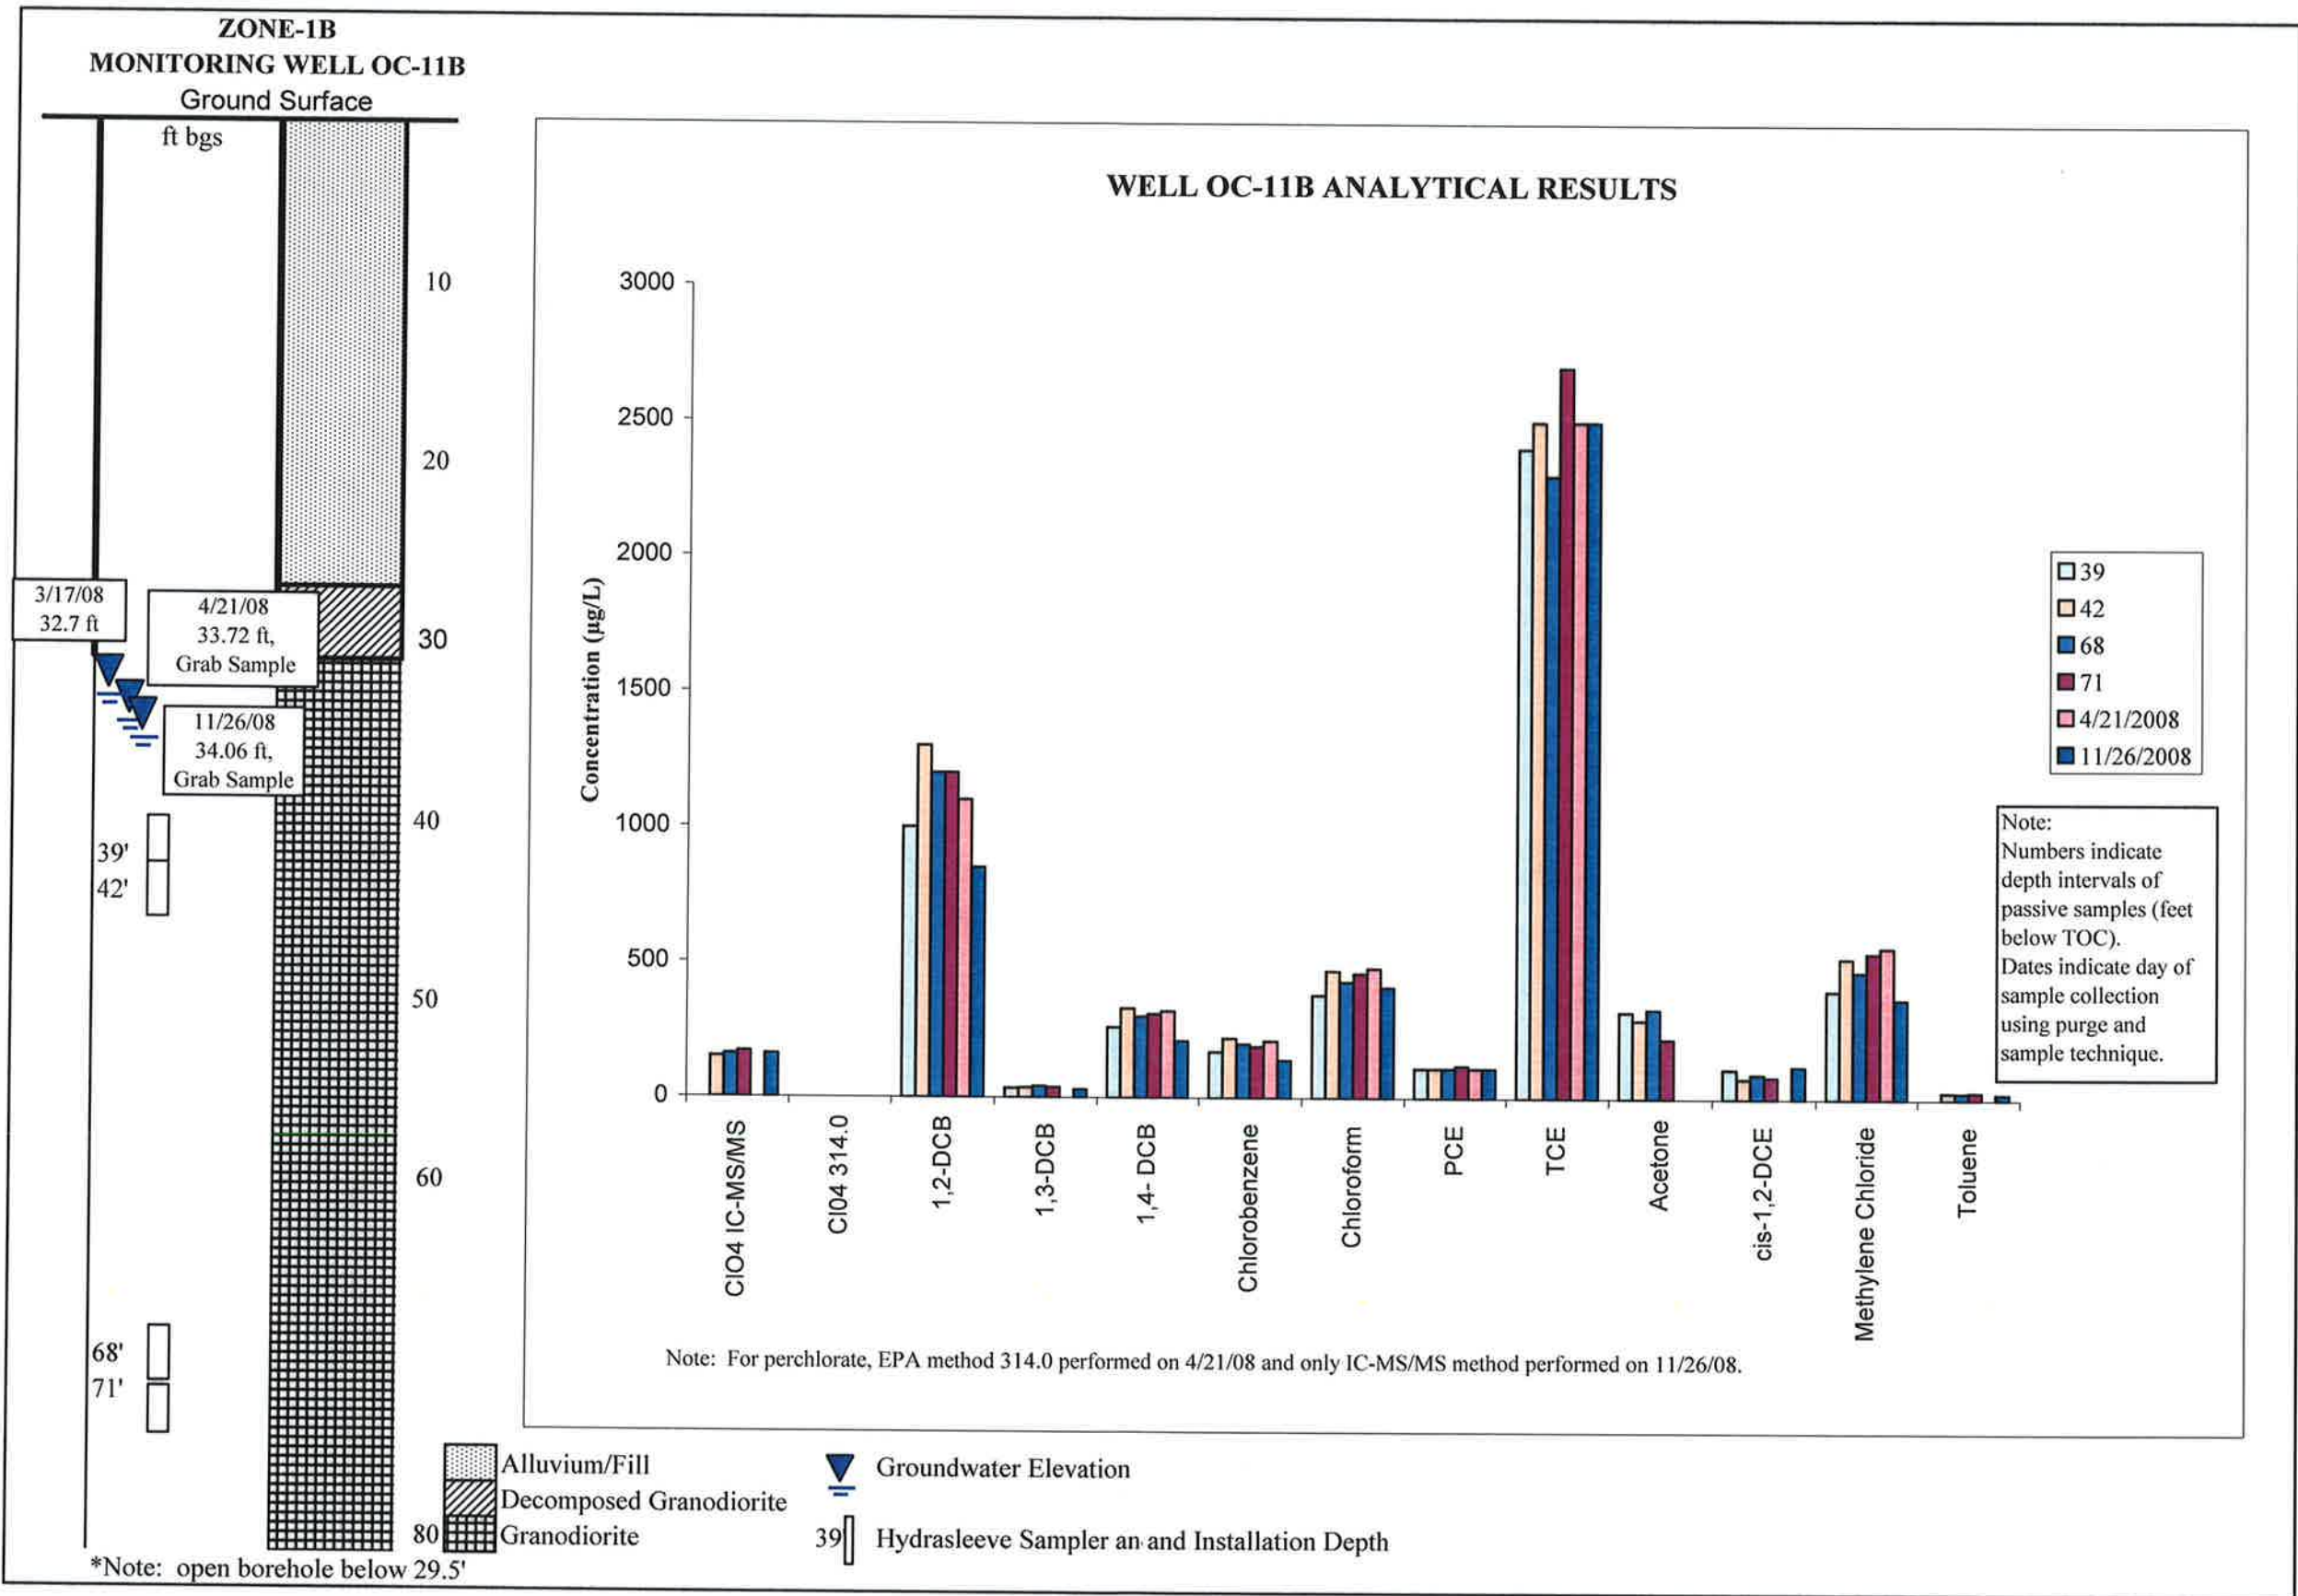


FIGURE 3-1 WELL OC-11B RESULTS

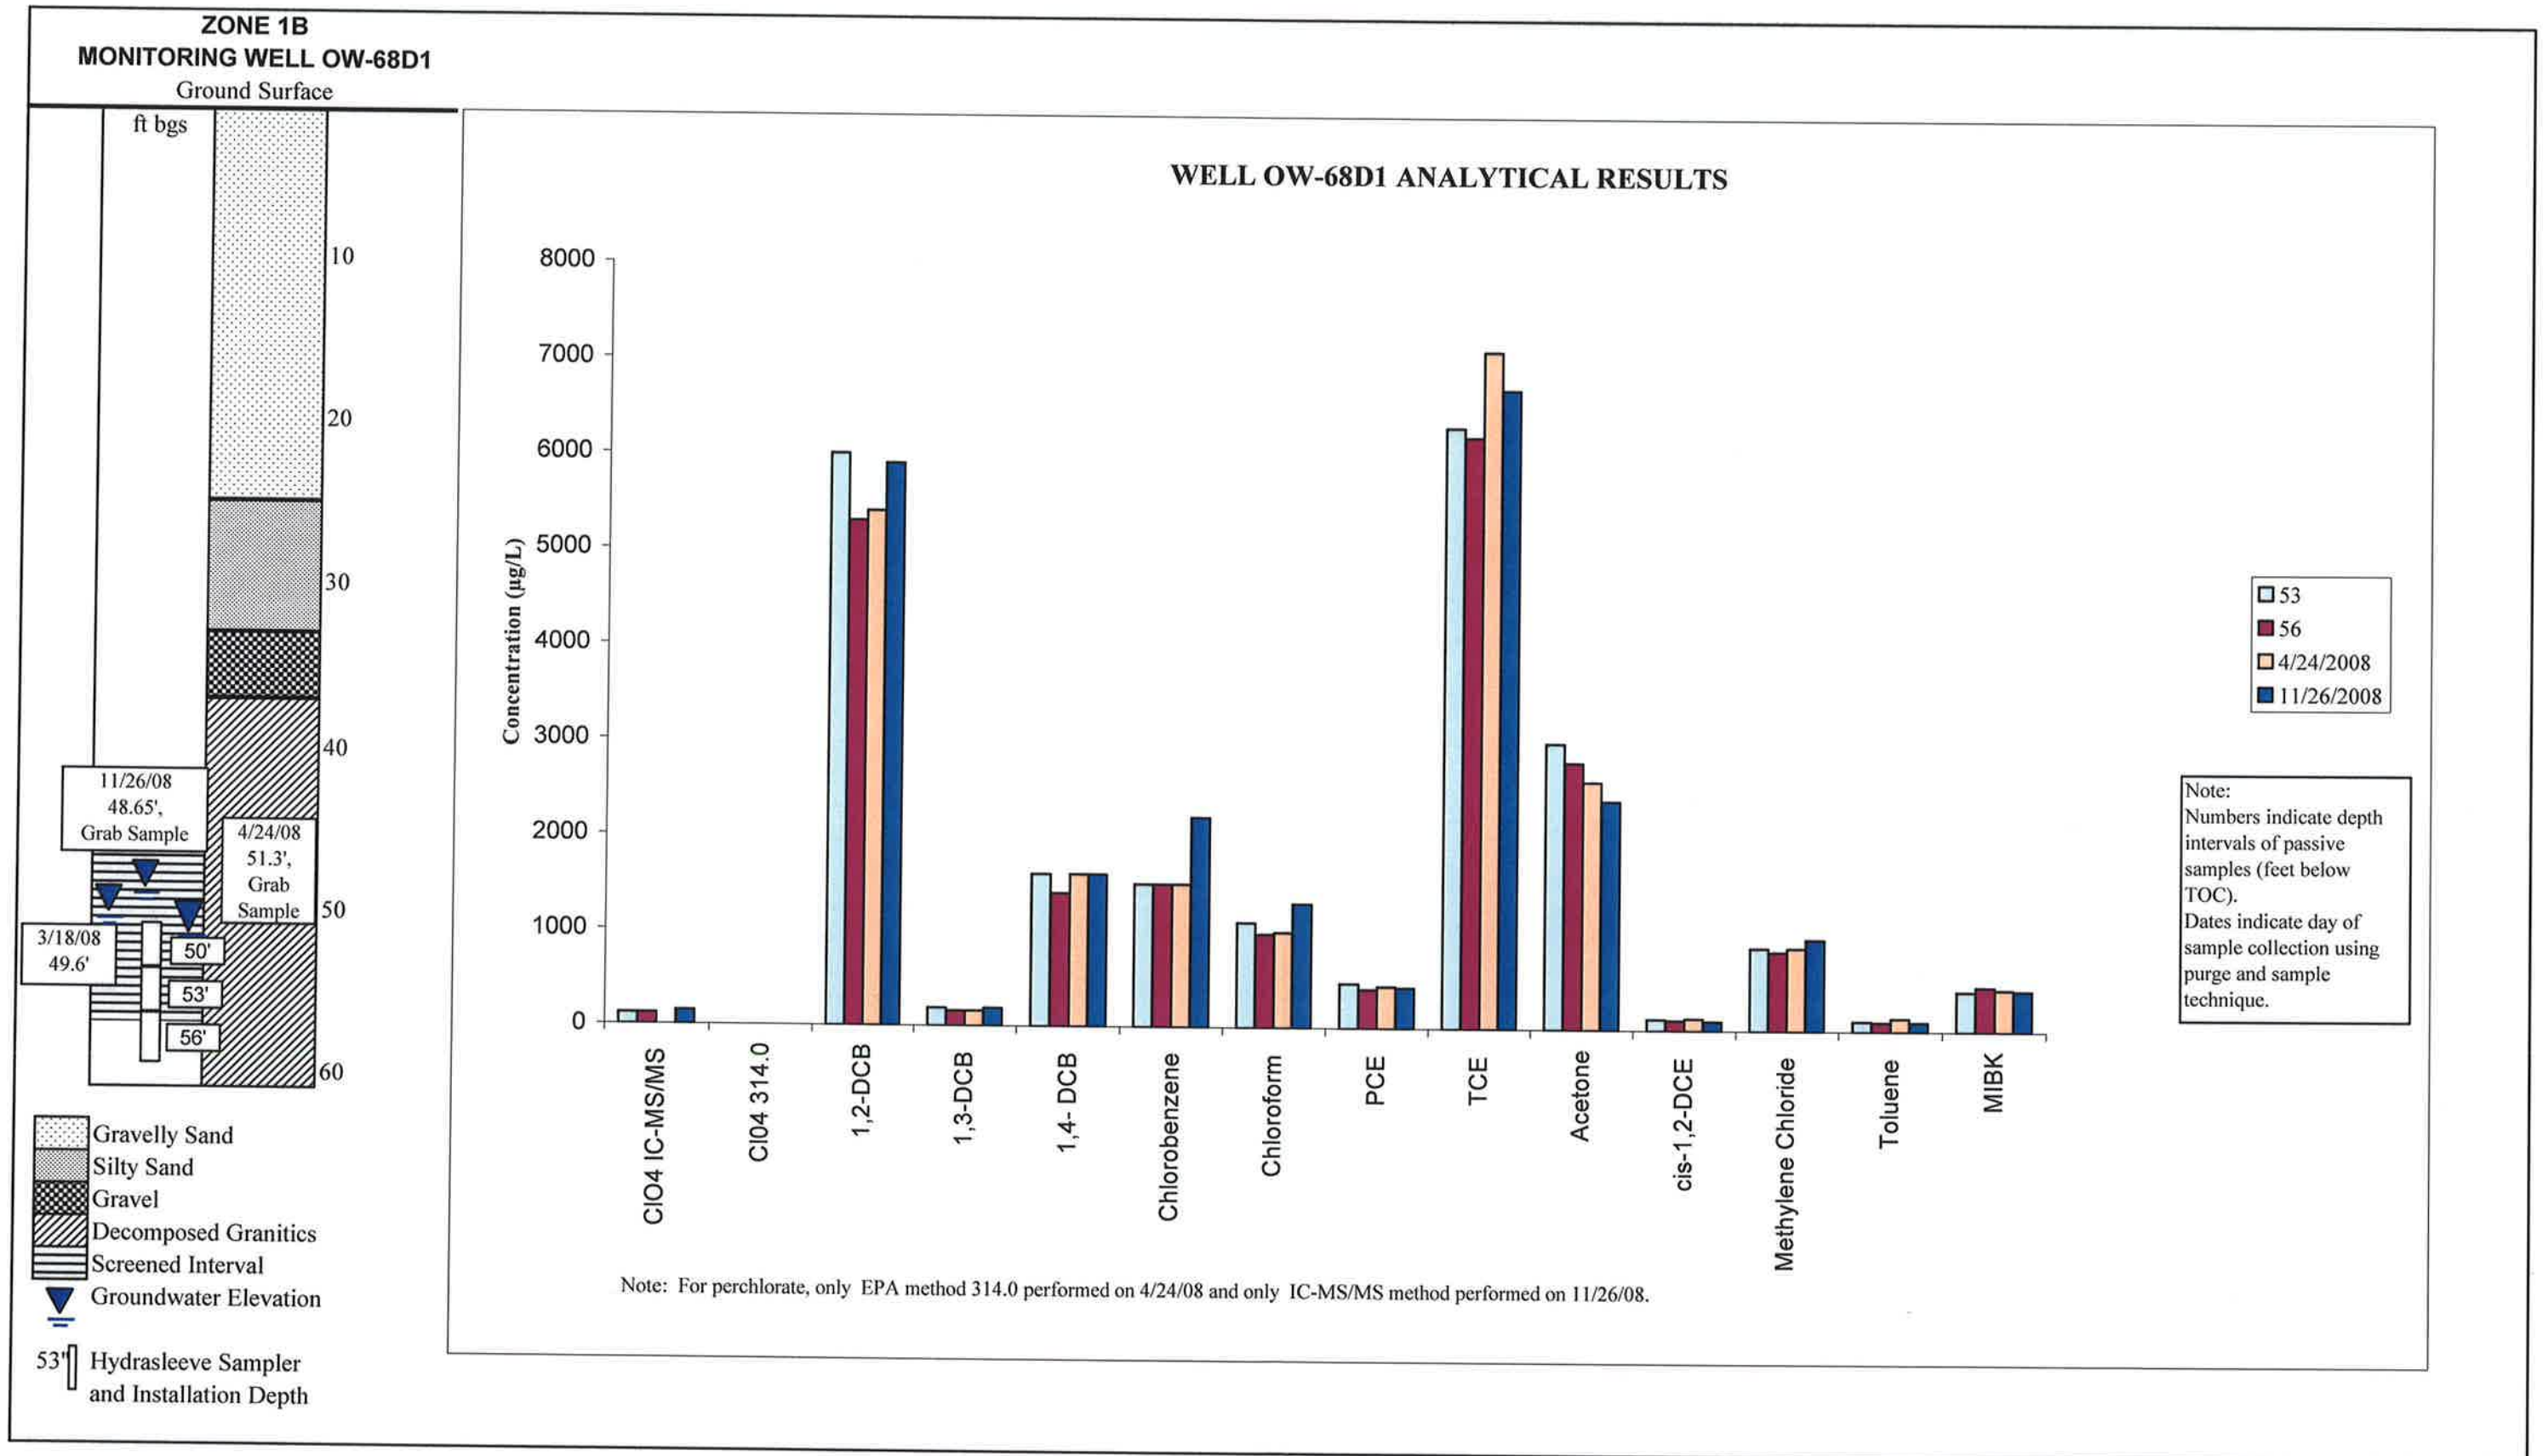


FIGURE 3-2 WELL OW-68D1 RESULTS

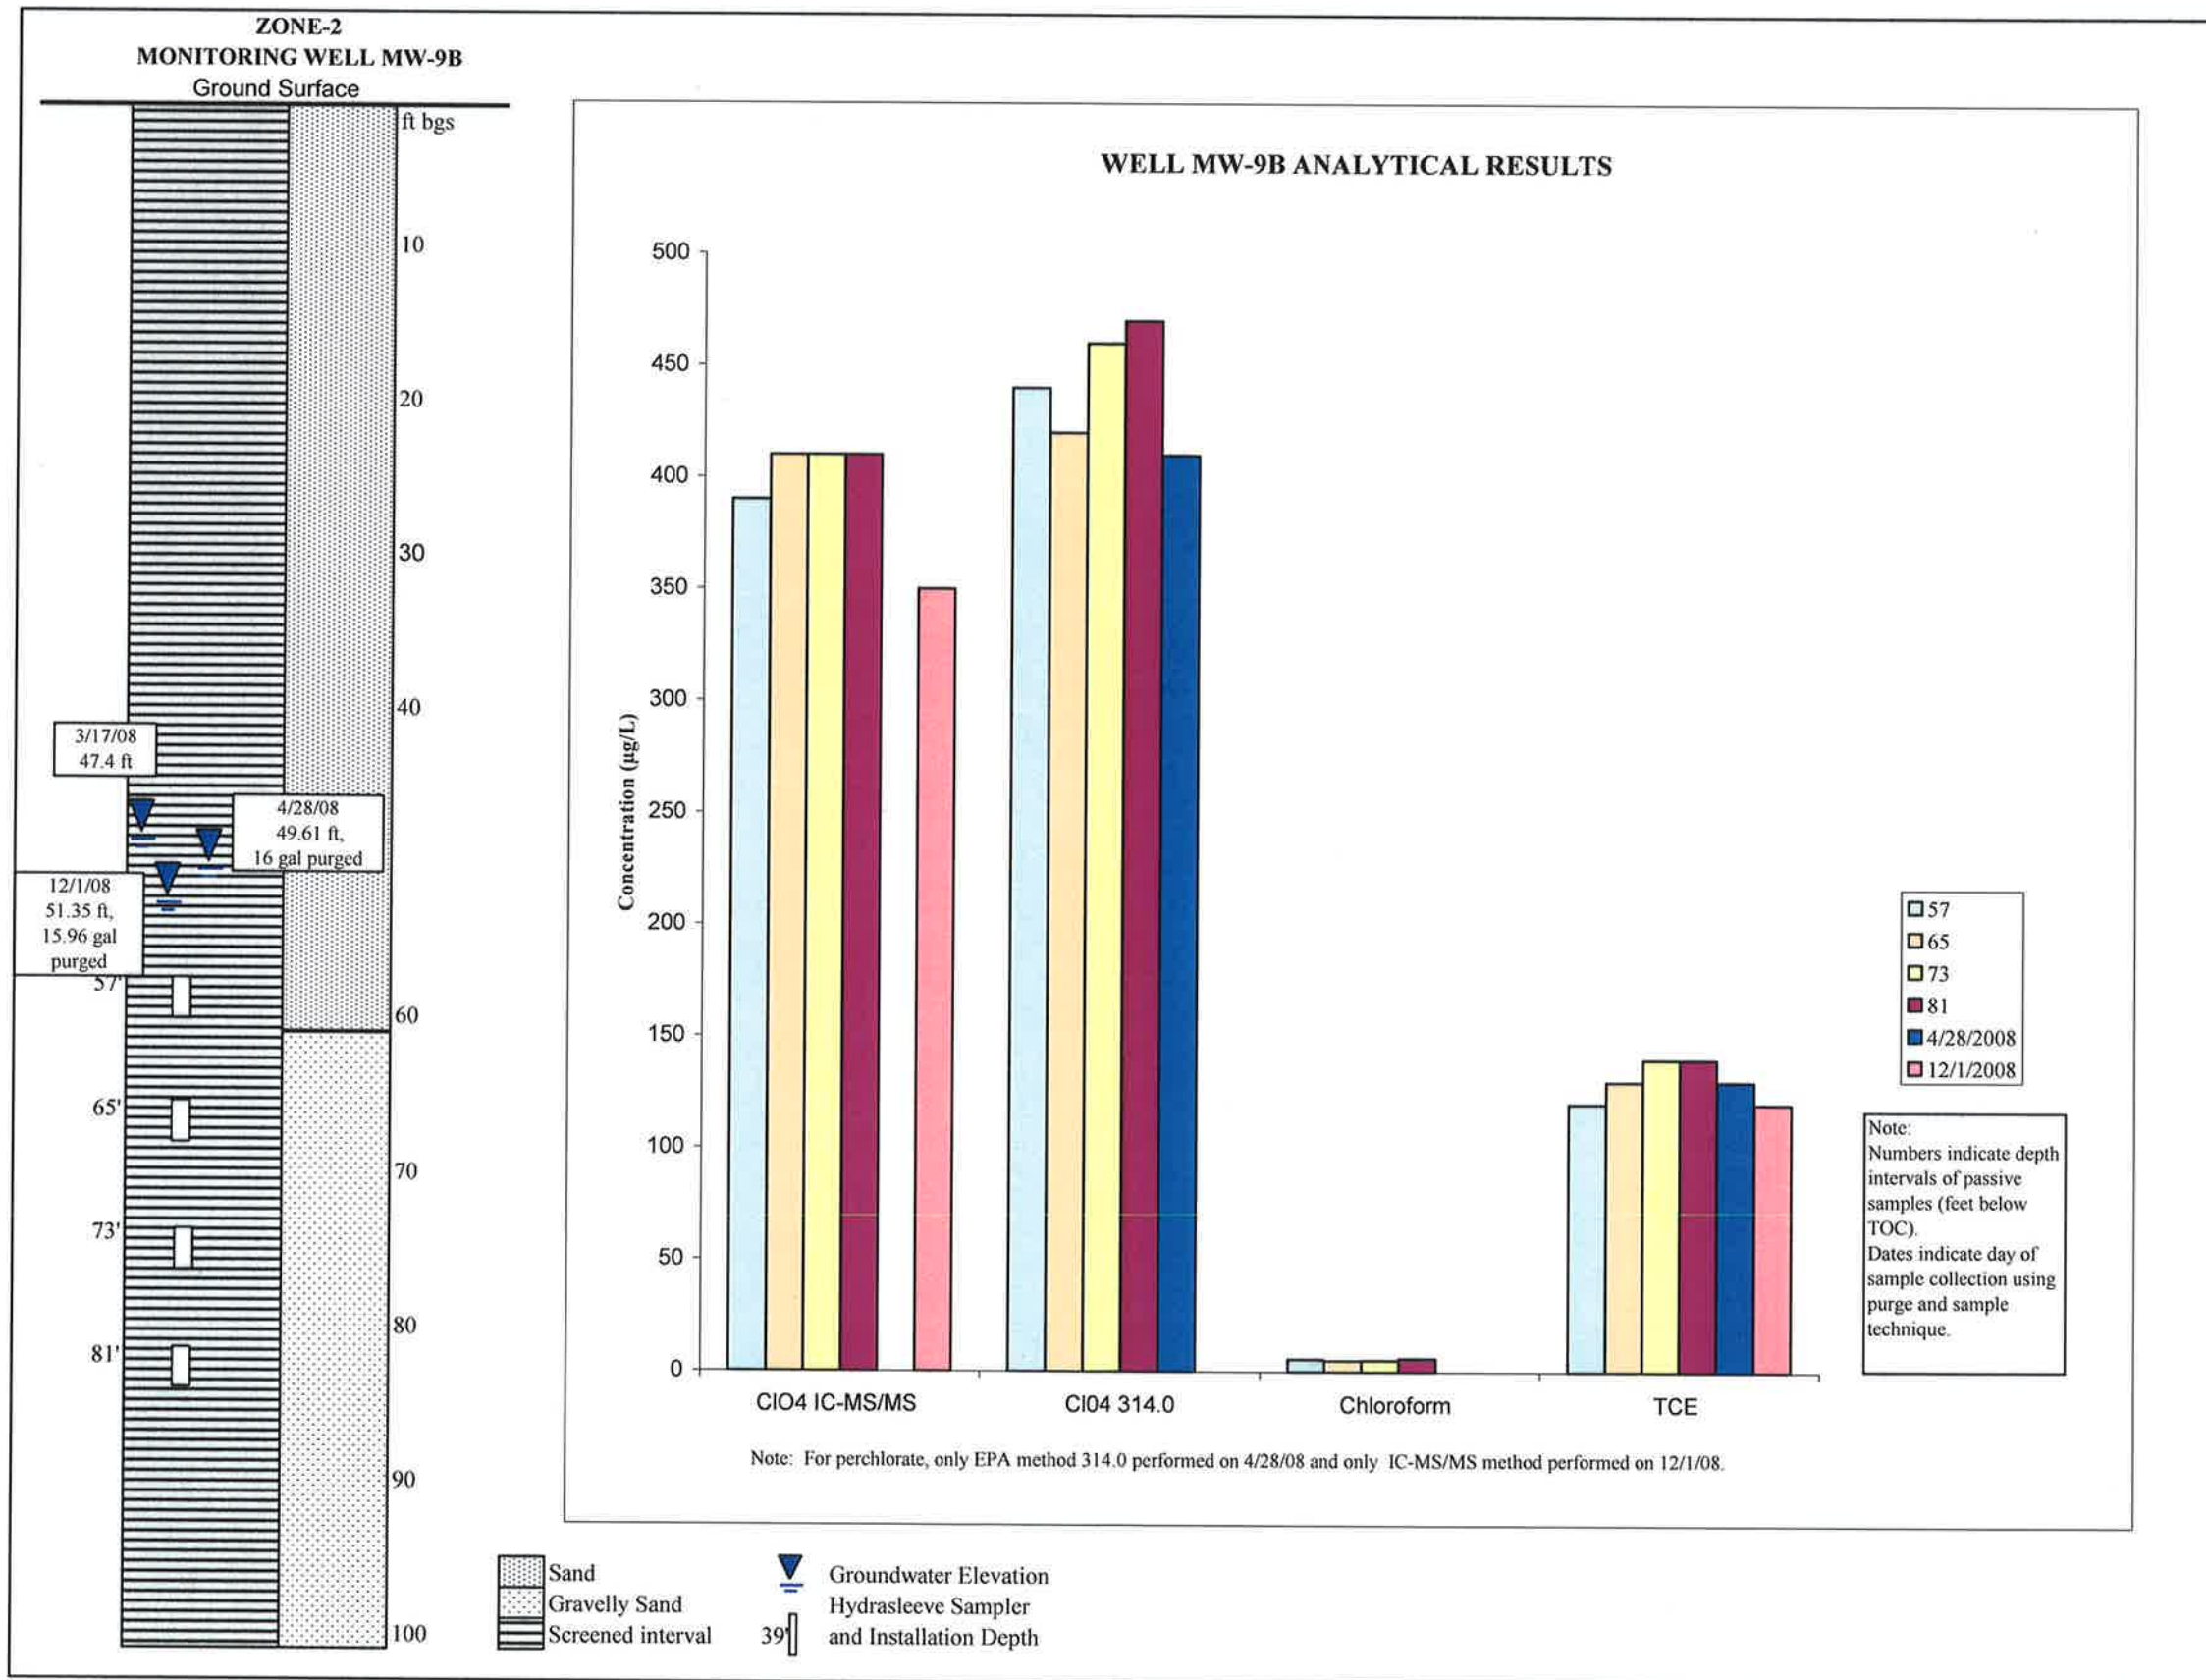


FIGURE 3-3 WELL MW-9B RESULTS

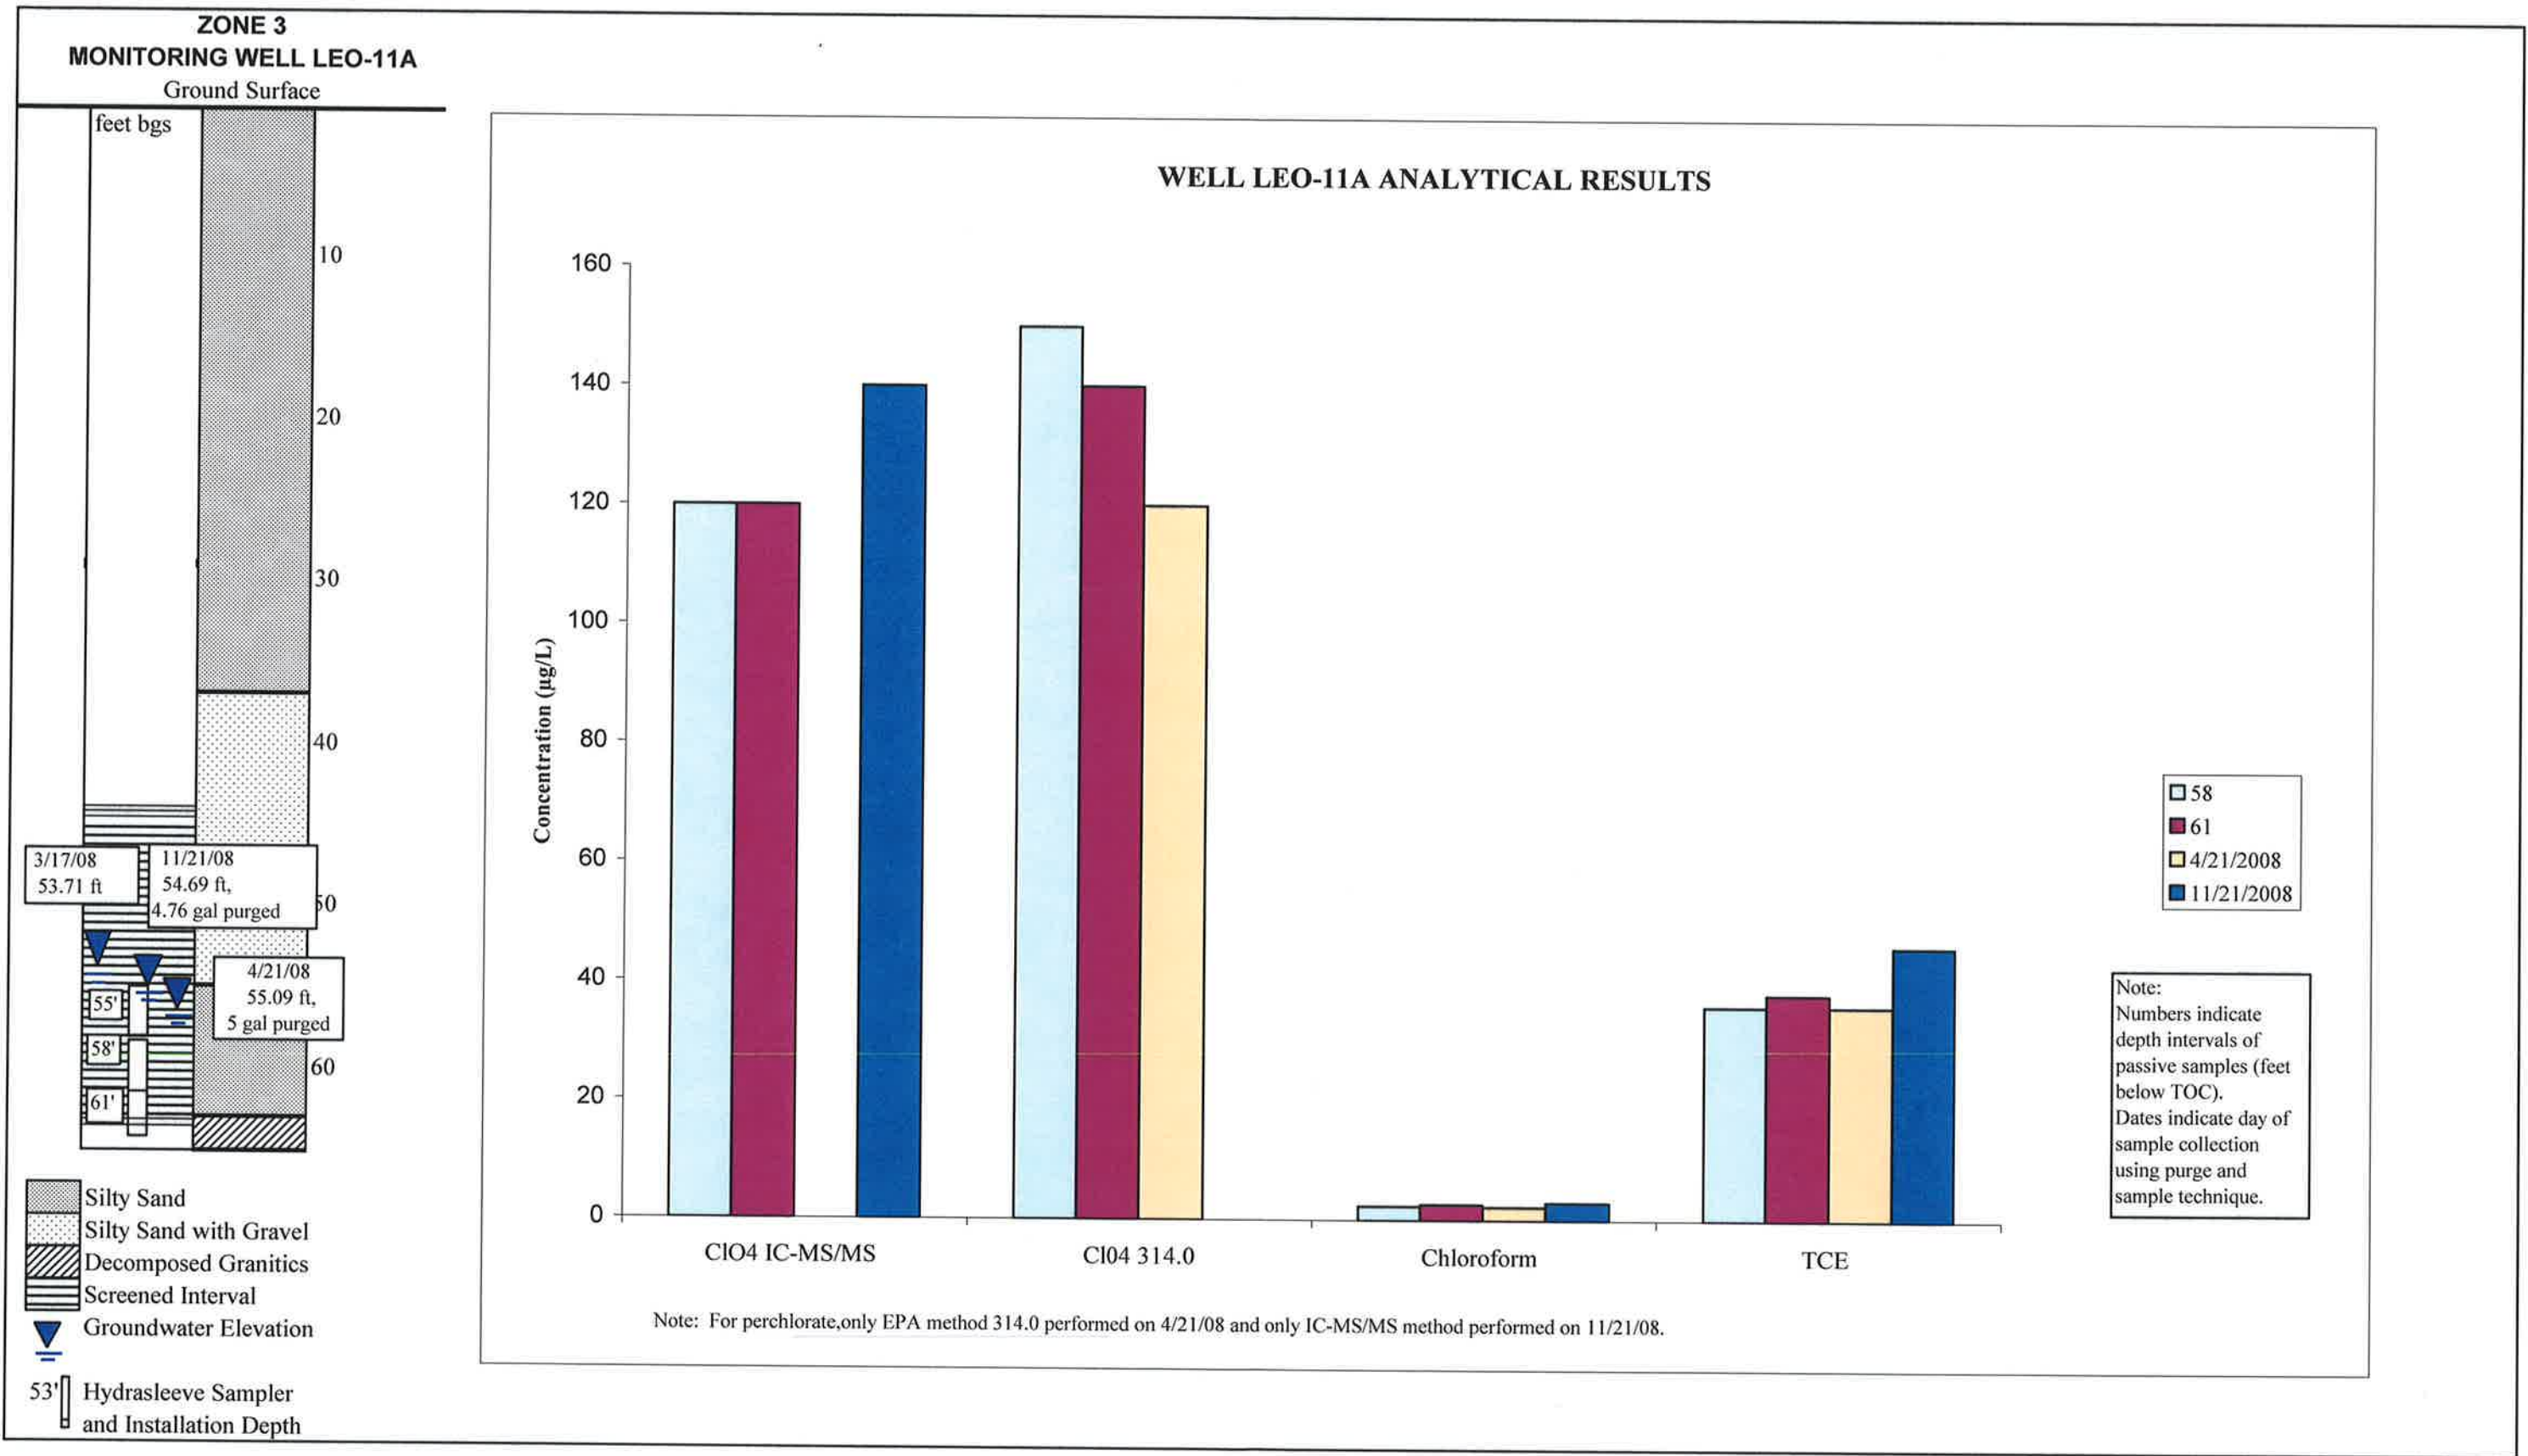


FIGURE 3-4 WELL LEO-11A RESULTS

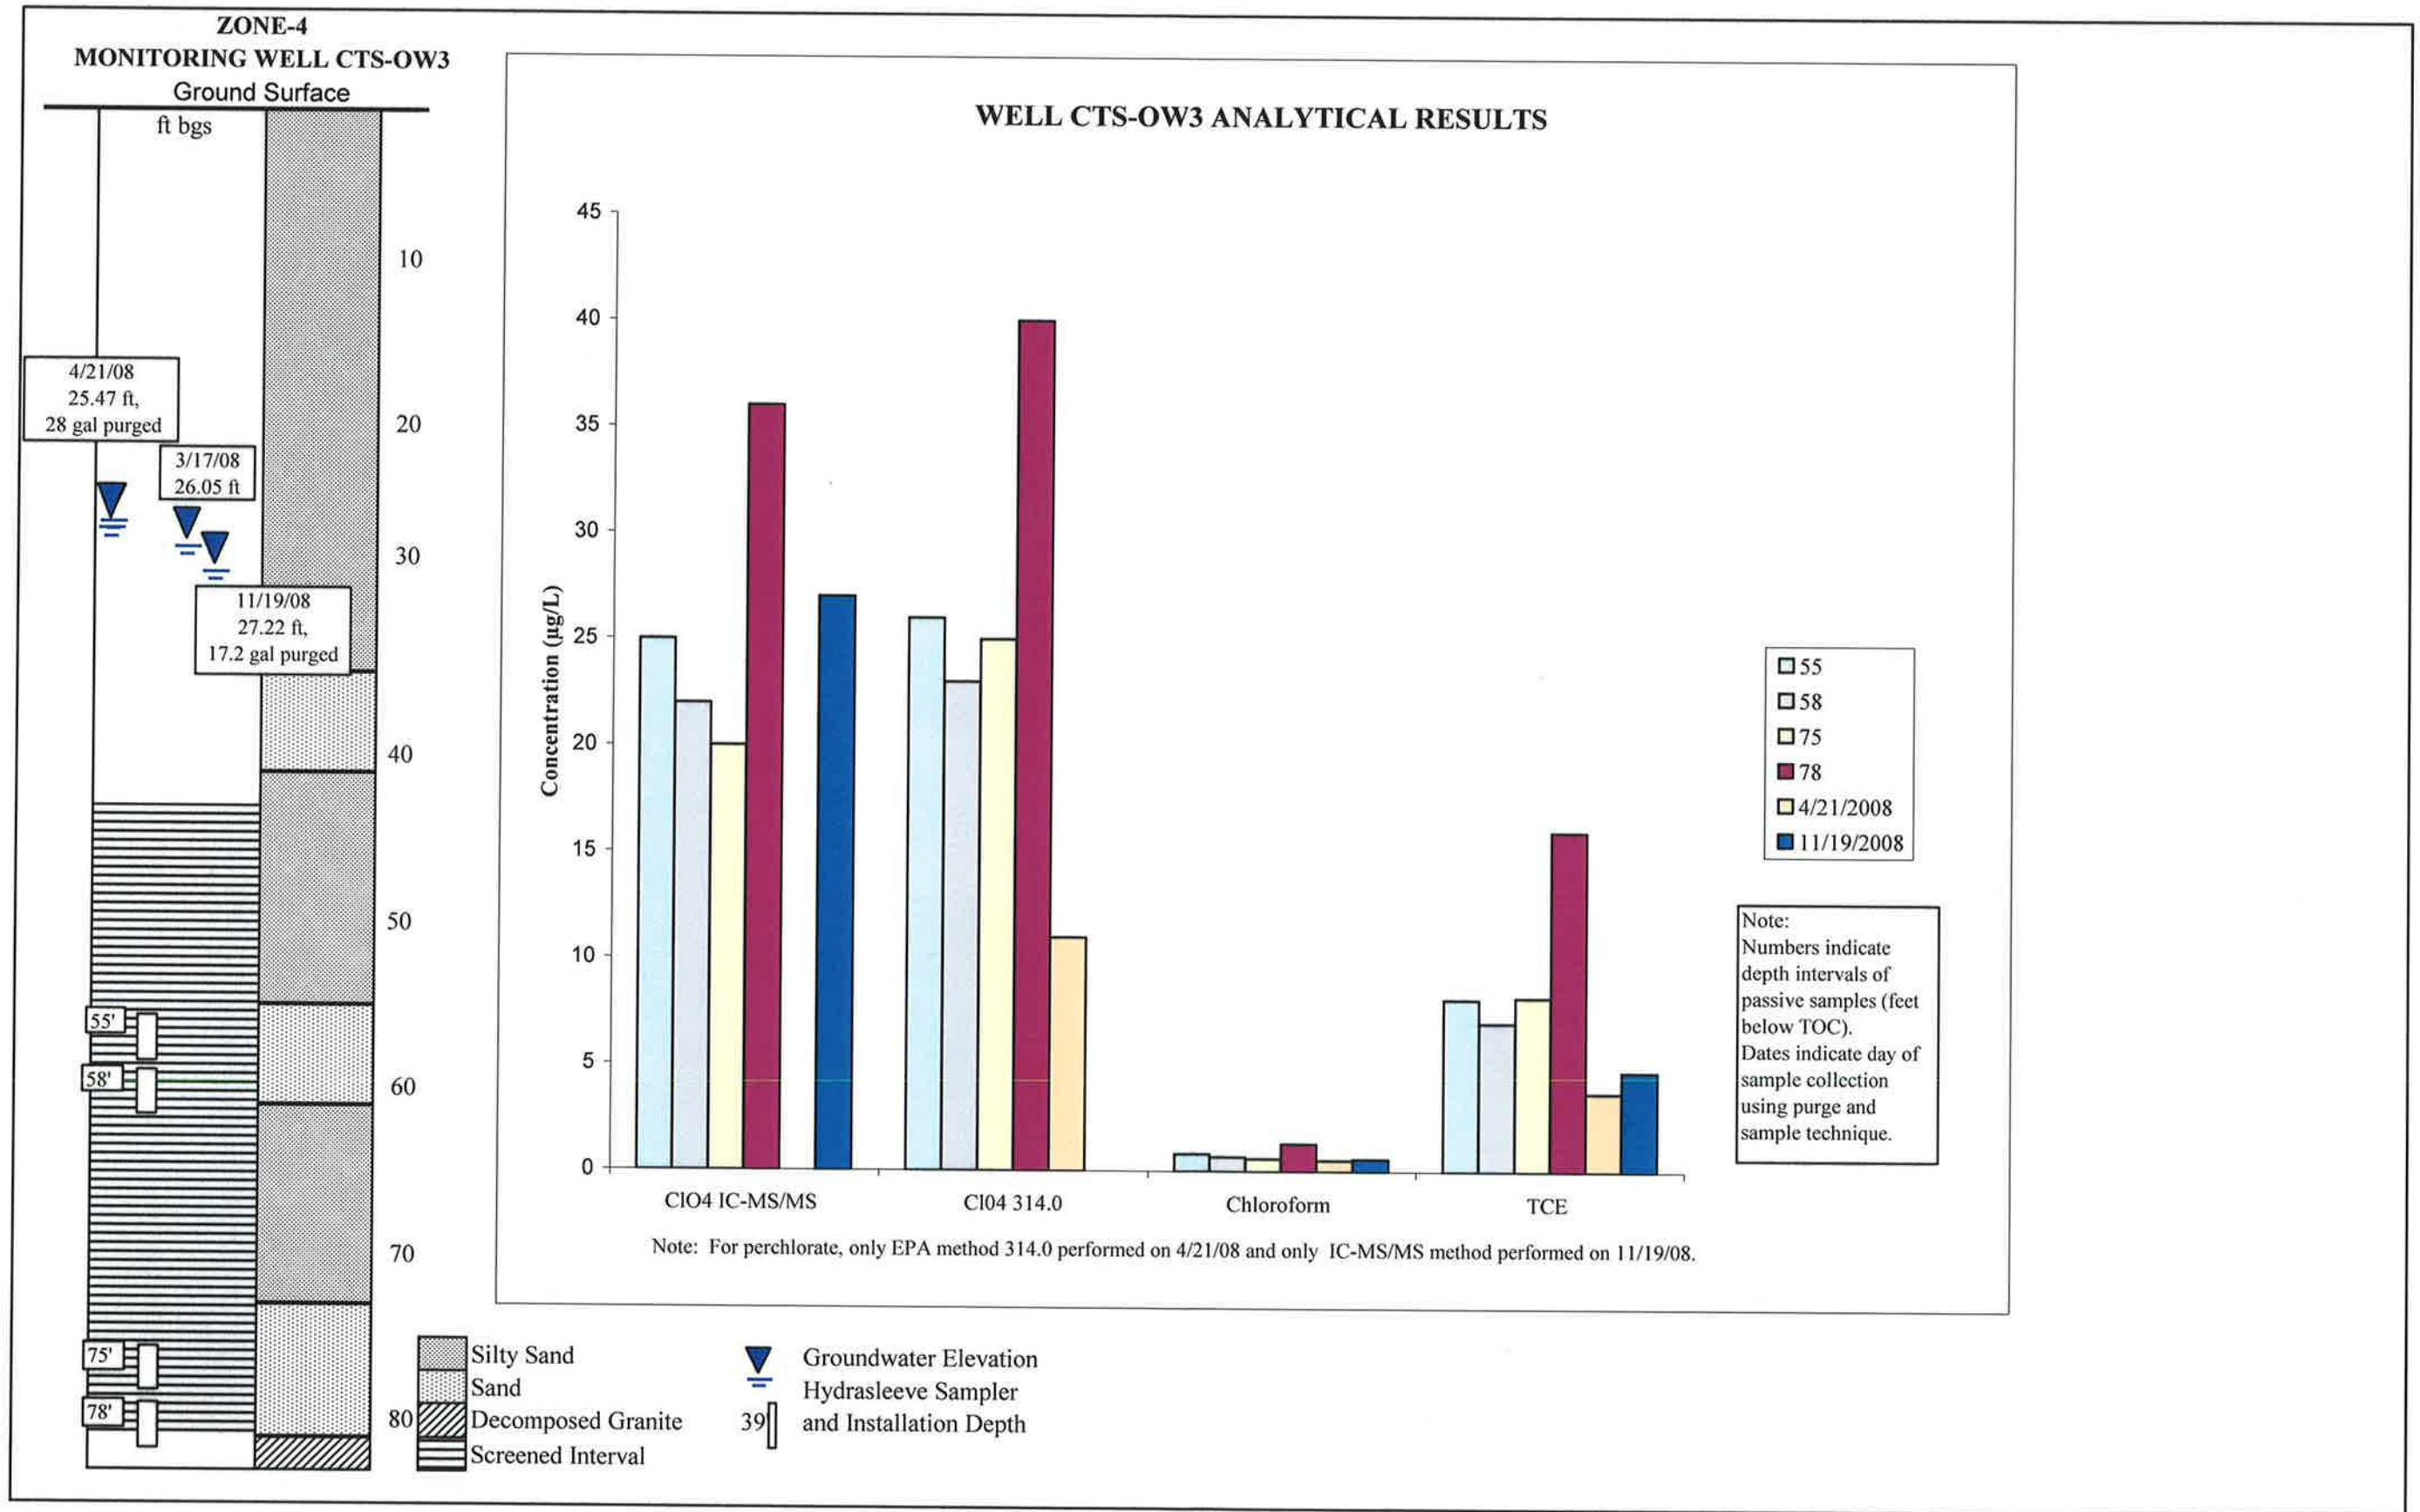


FIGURE 3-5 WELL CTS-OW3 RESULTS

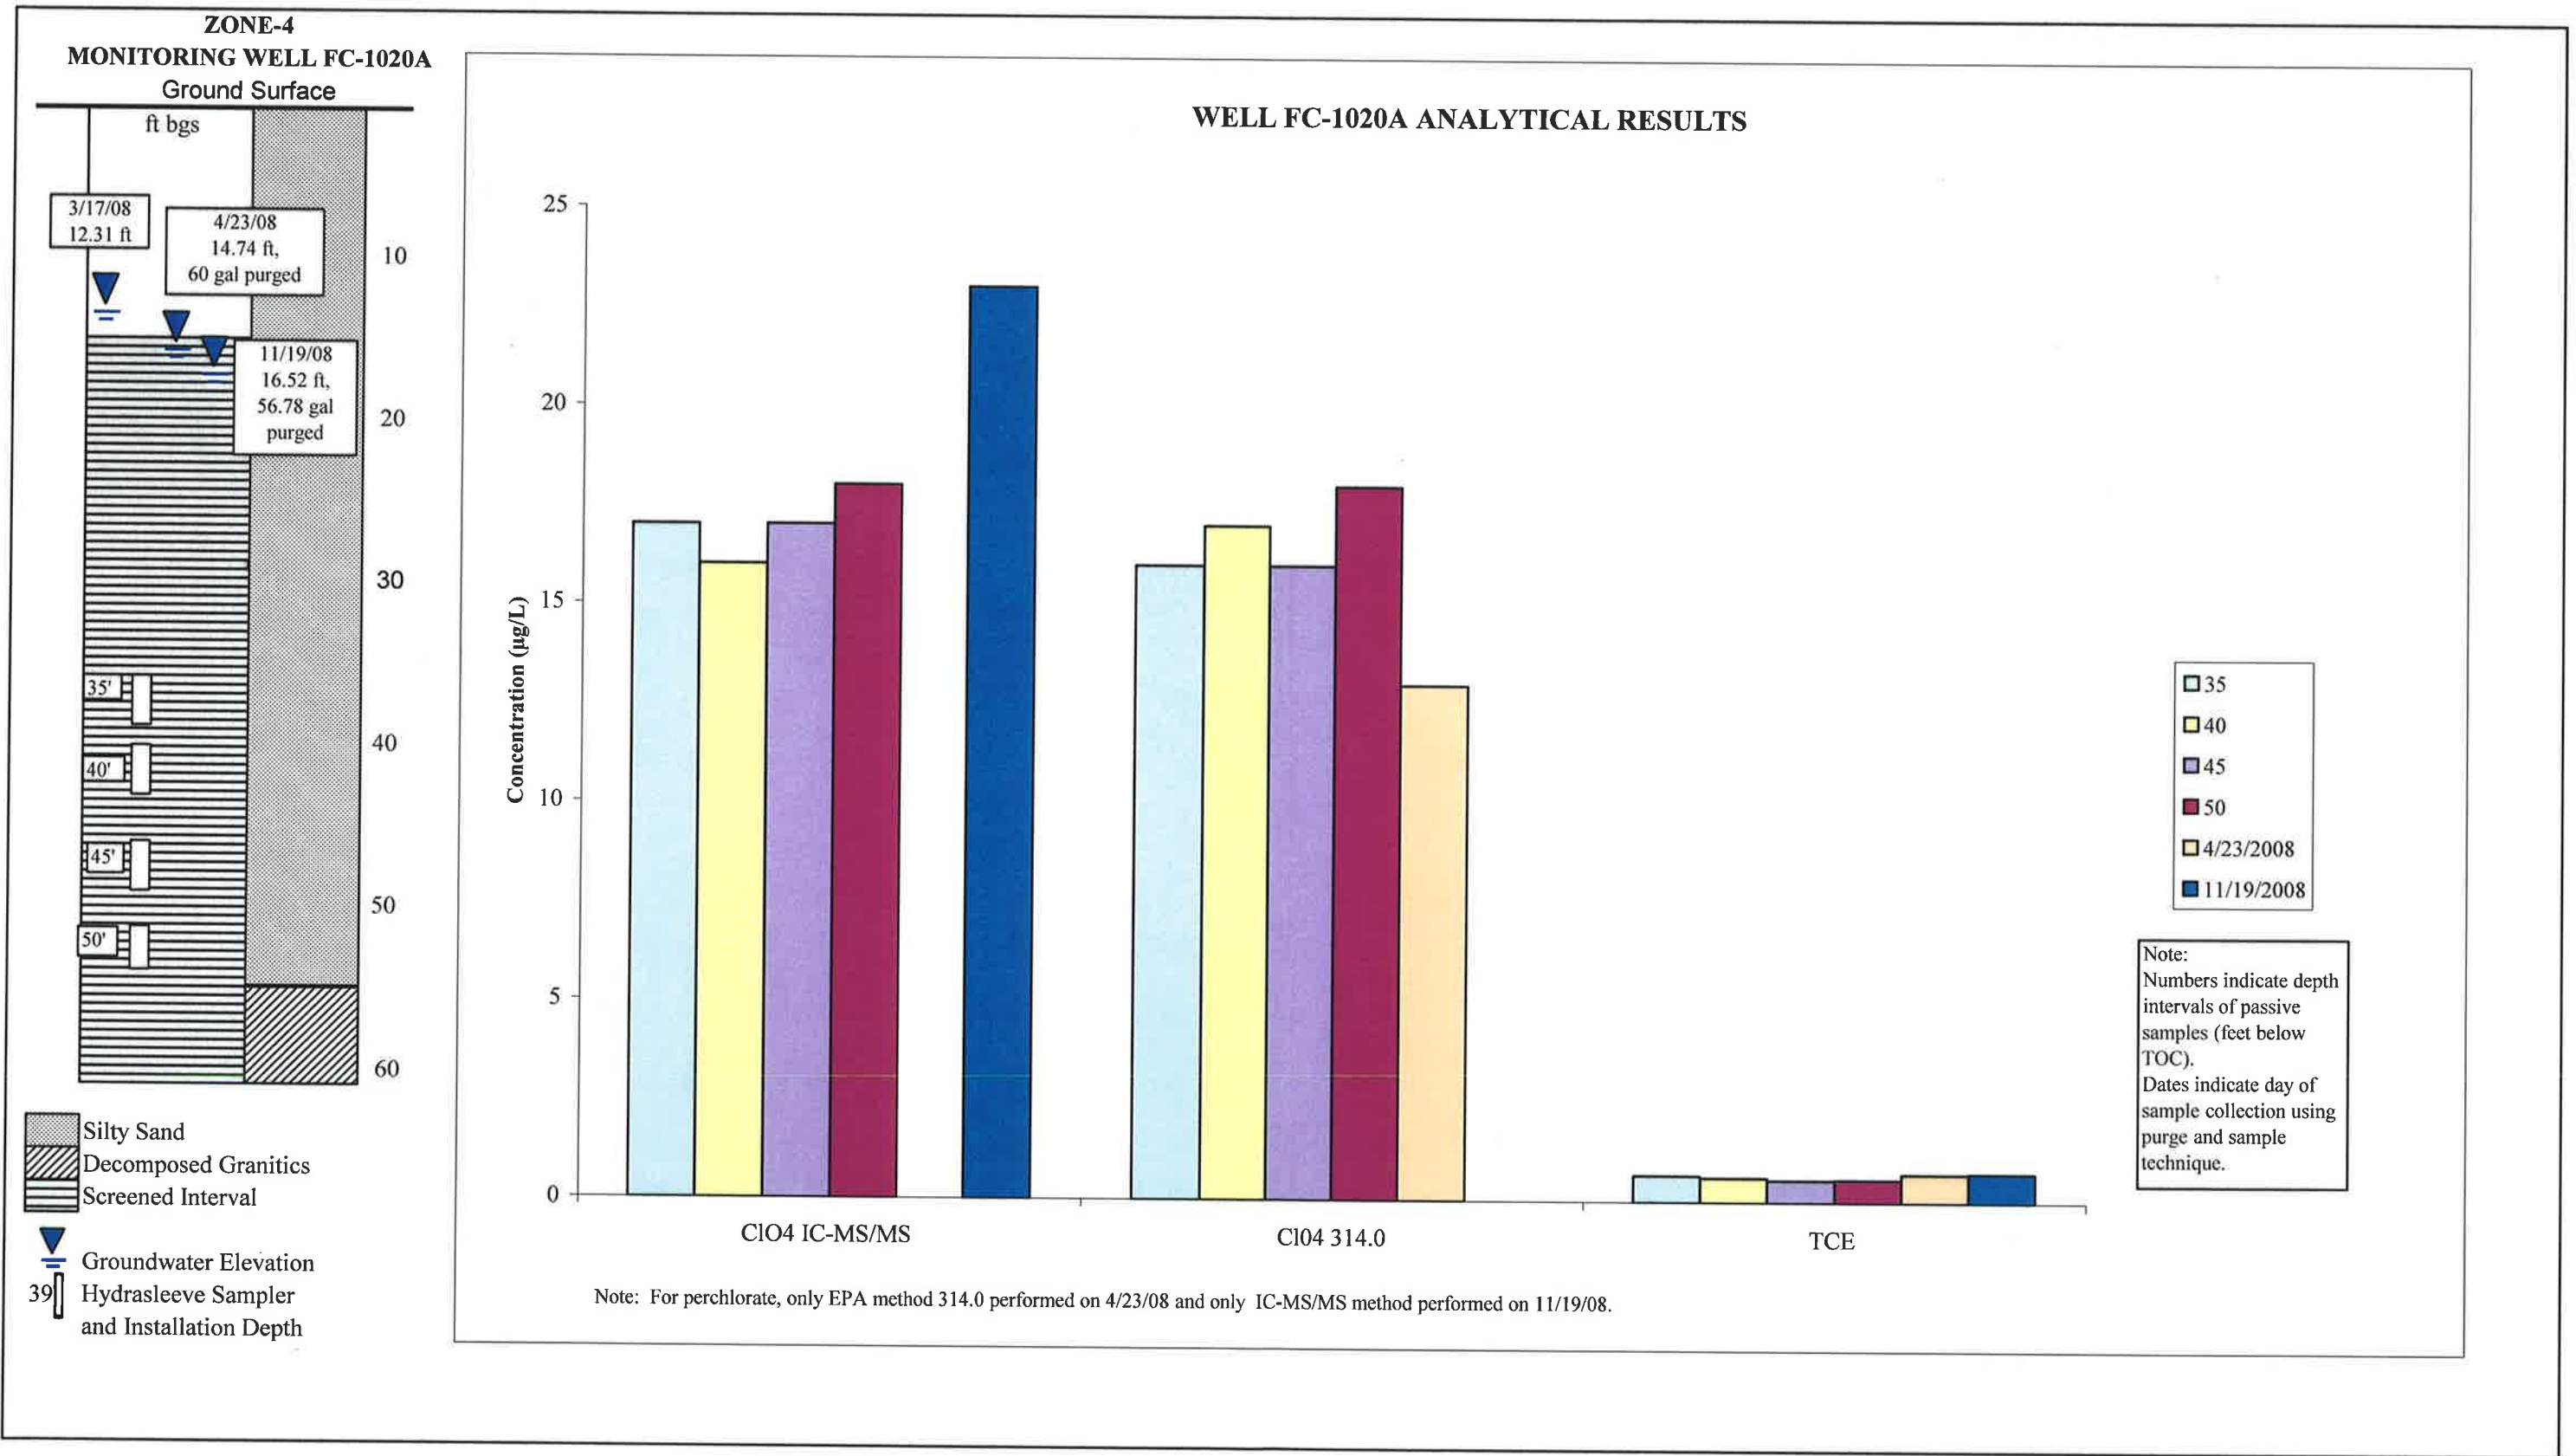


FIGURE 3-6 WELL FC-1020A RESULTS

FIGURE 3-7
COMPARISON OF PERCHLORATE CONCENTRATIONS IN PASSIVE SAMPLES

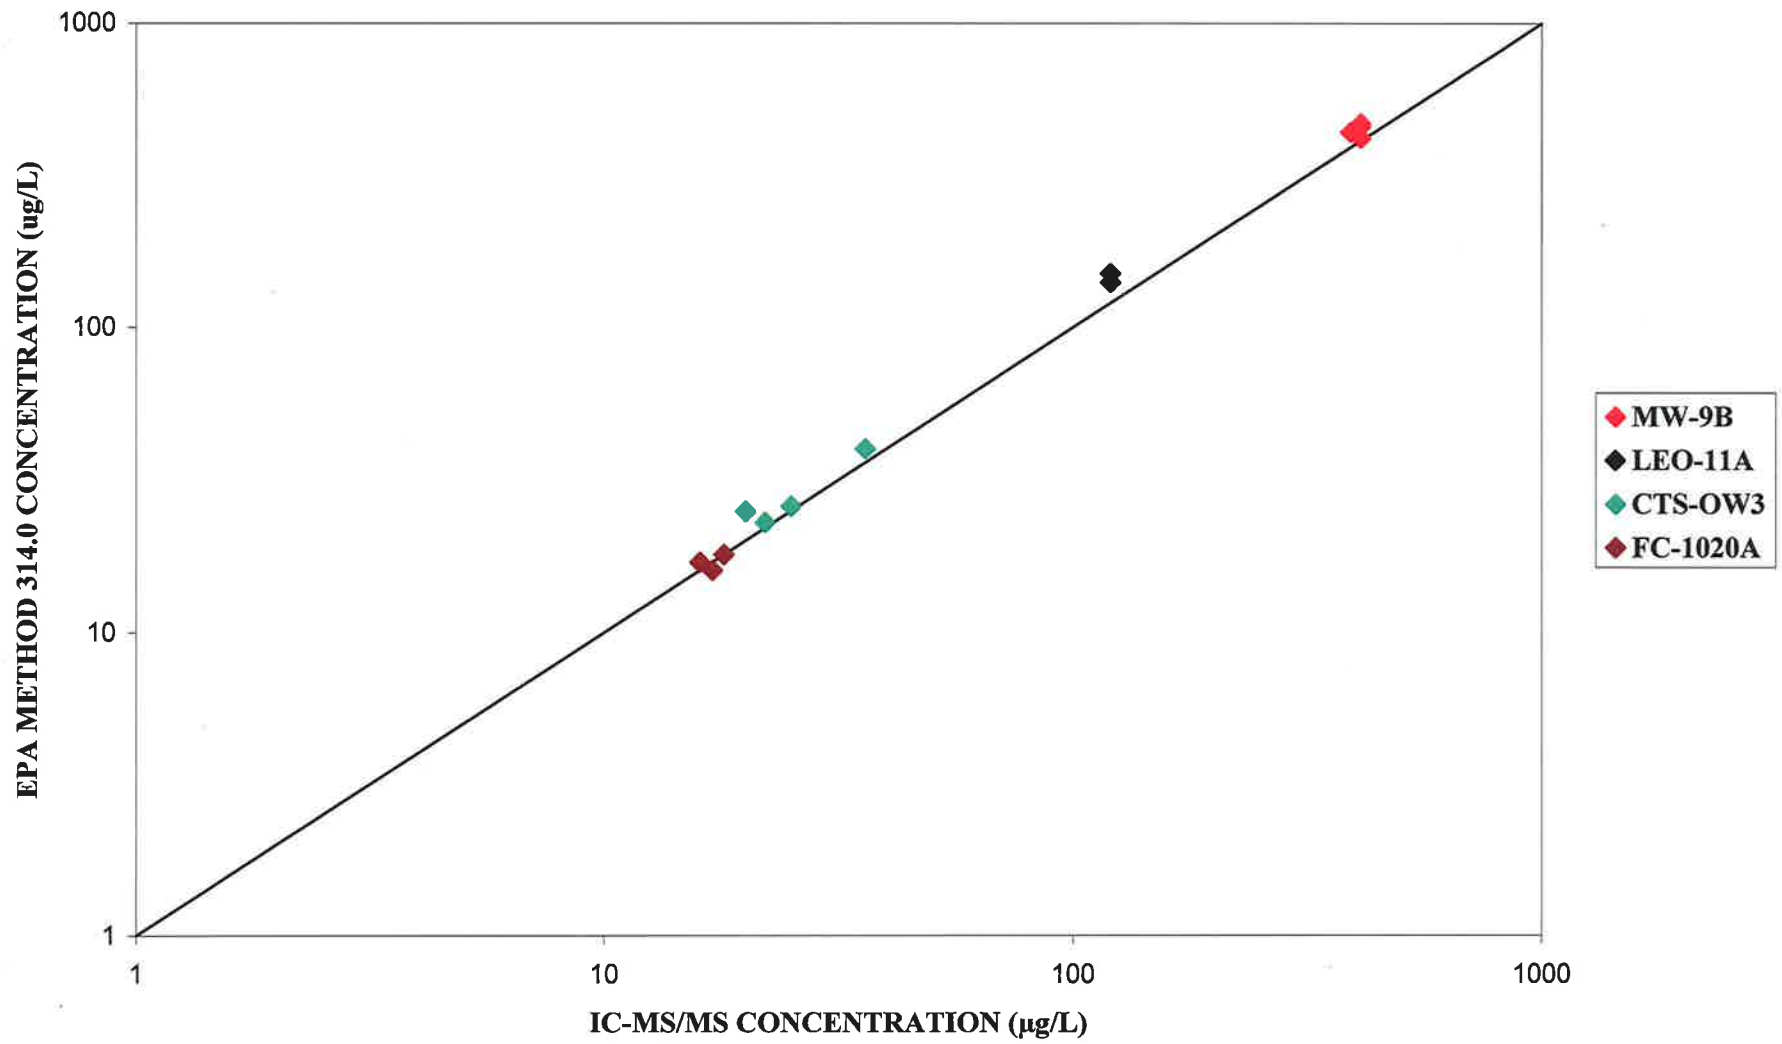
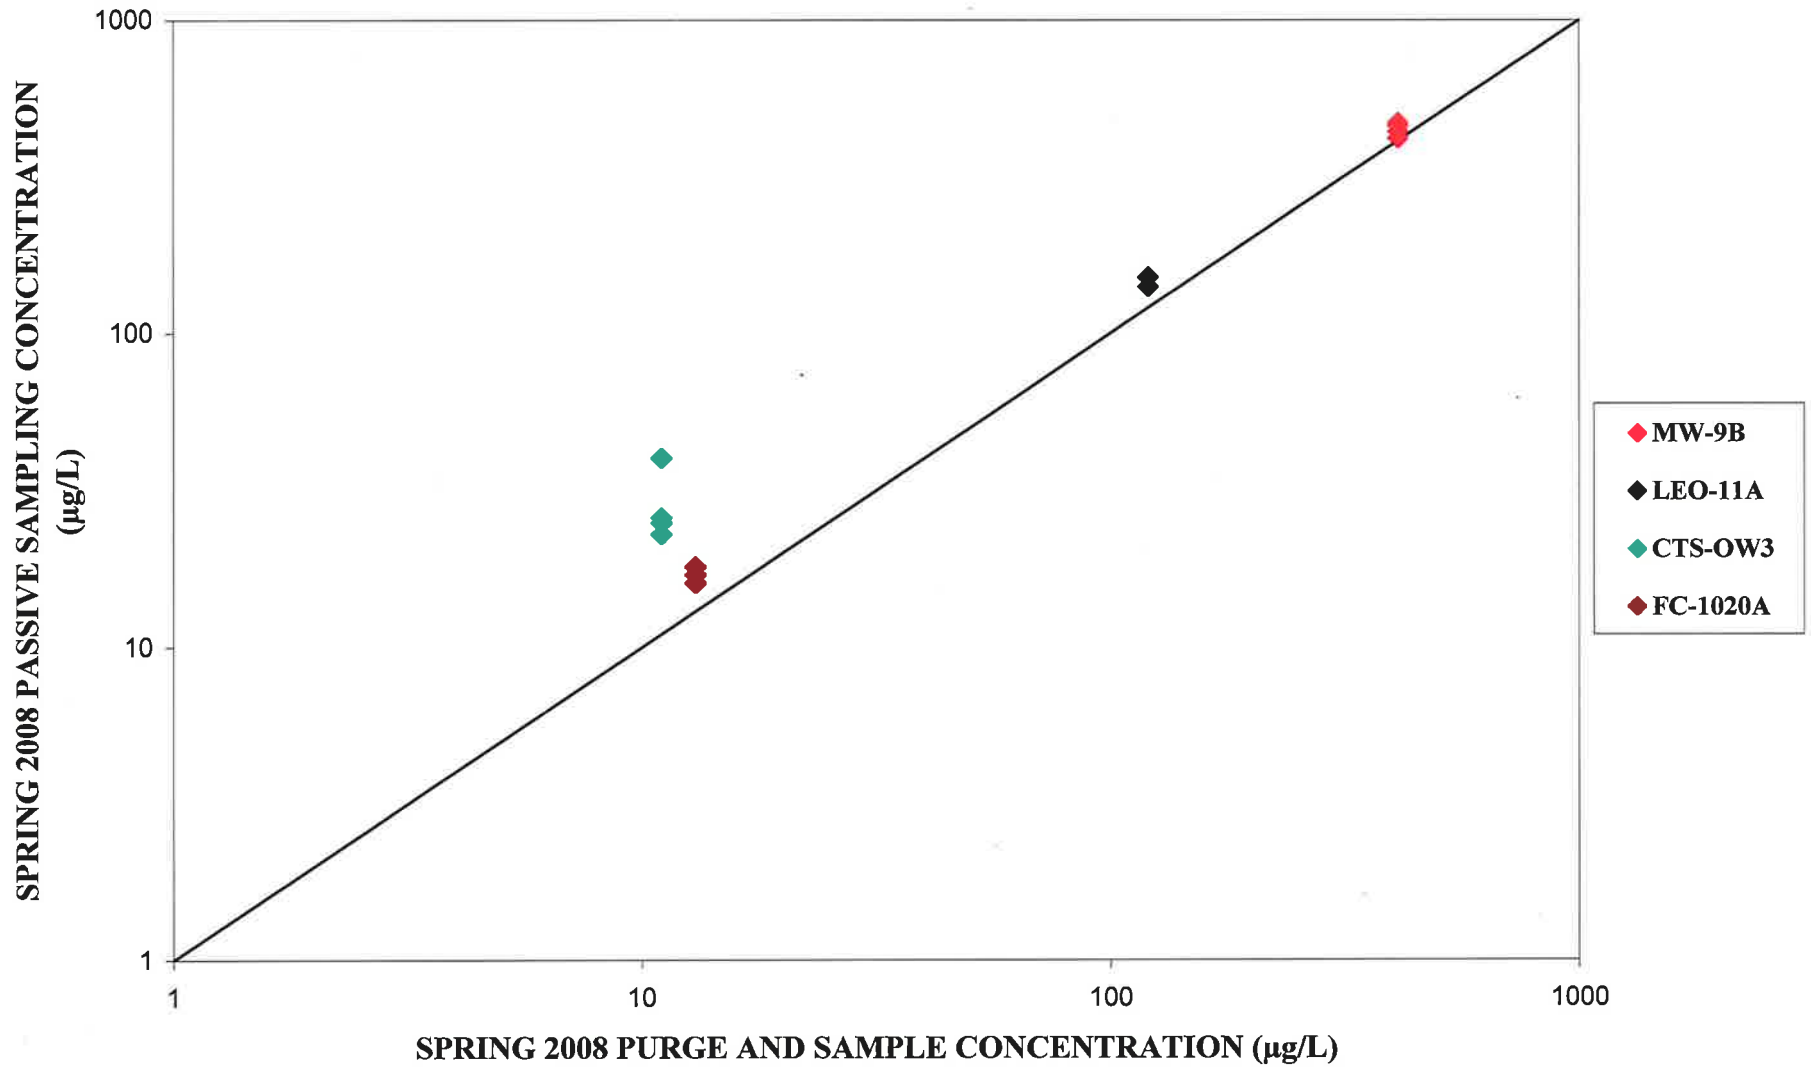


FIGURE 3-8
COMPARISON OF PERCHLORATE (EPA METHOD 314.0) CONCENTRATIONS



**FIGURE 3-9
COMPARISON OF PERCHLORATE (IC-MS/MS) CONCENTRATIONS**

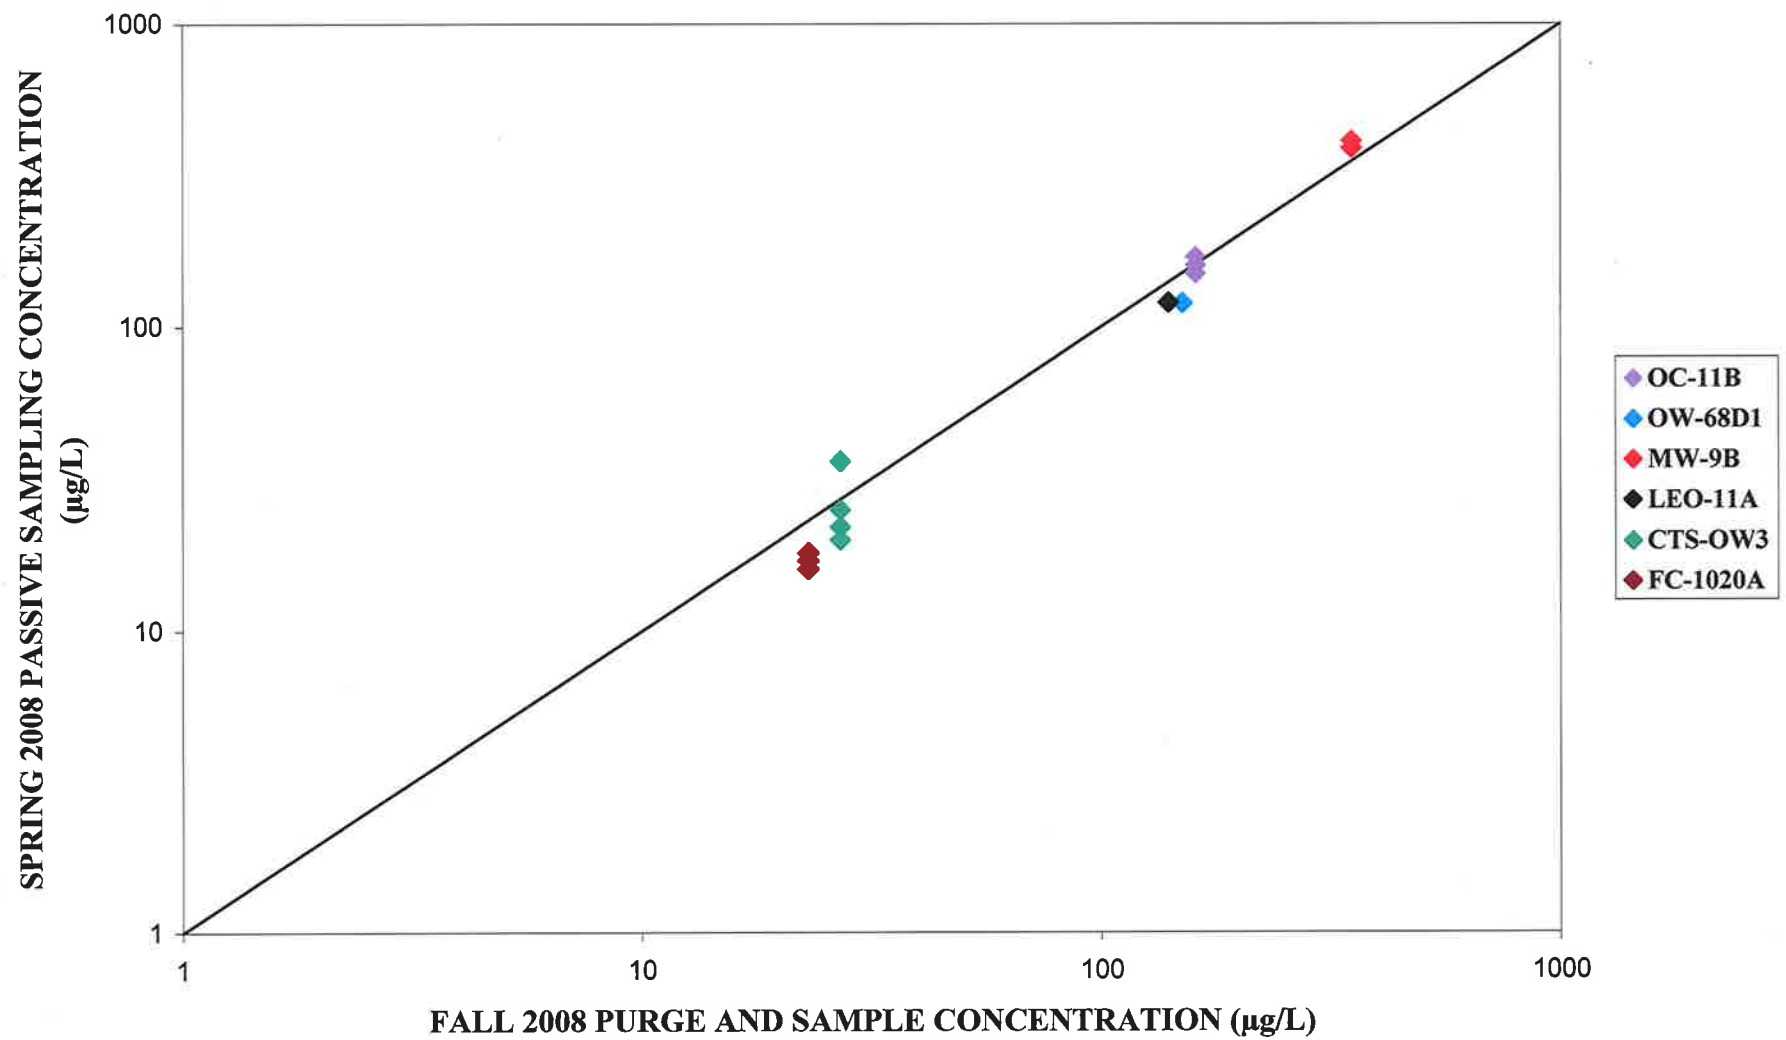
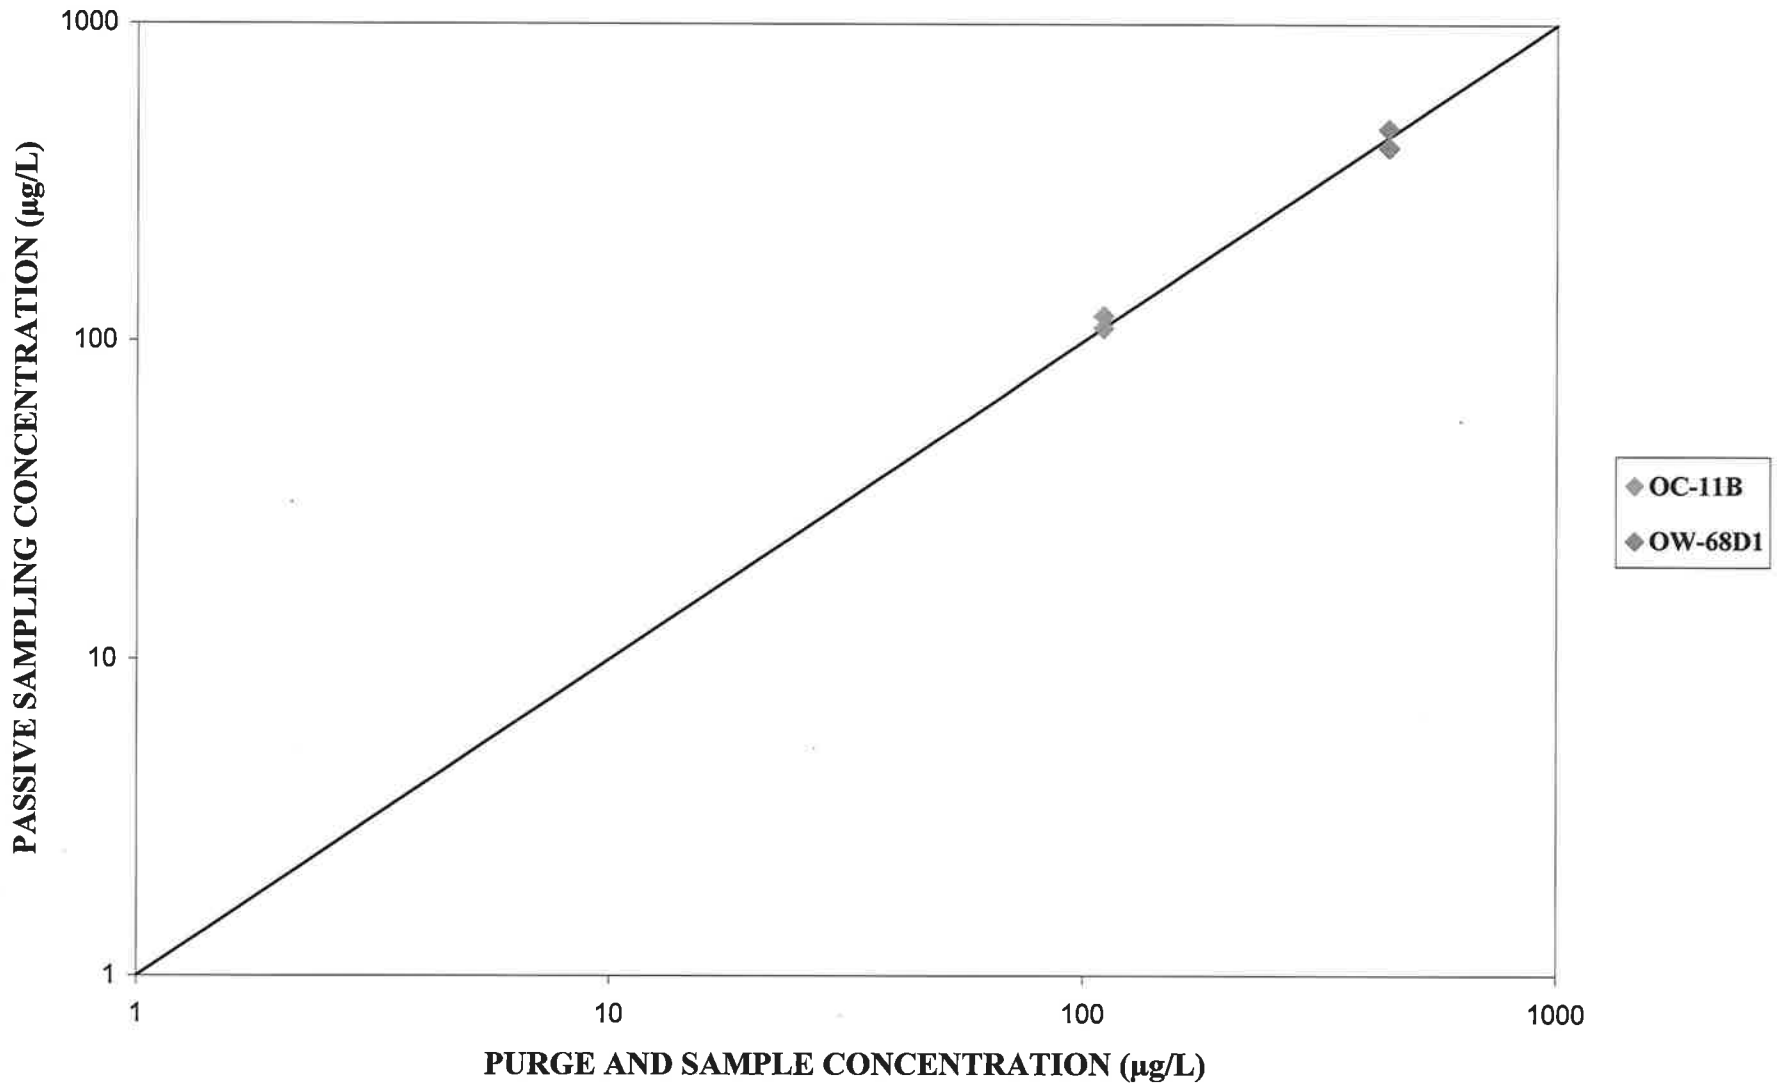


FIGURE 3-10
COMPARISON OF PCE CONCENTRATIONS



**FIGURE 3-11
COMPARISON OF TCE CONCENTRATIONS**

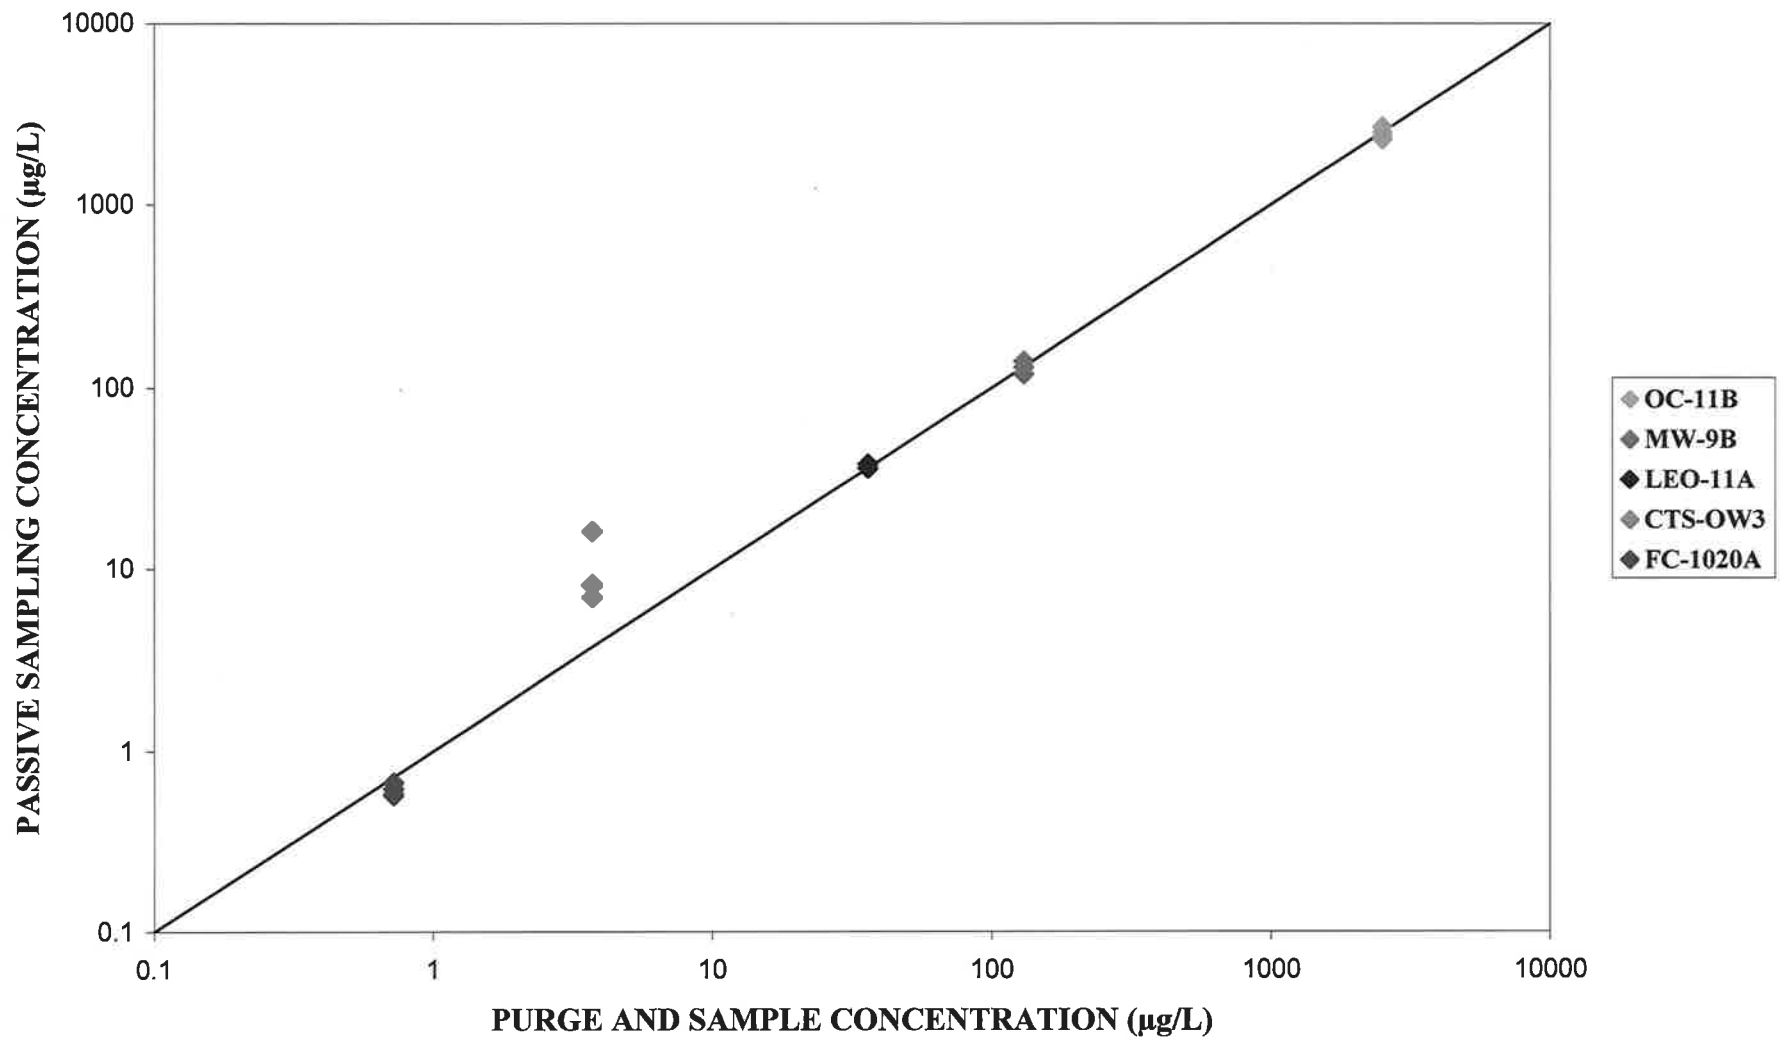


FIGURE 3-12
COMPARISON OF CHLOROFORM CONCENTRATIONS



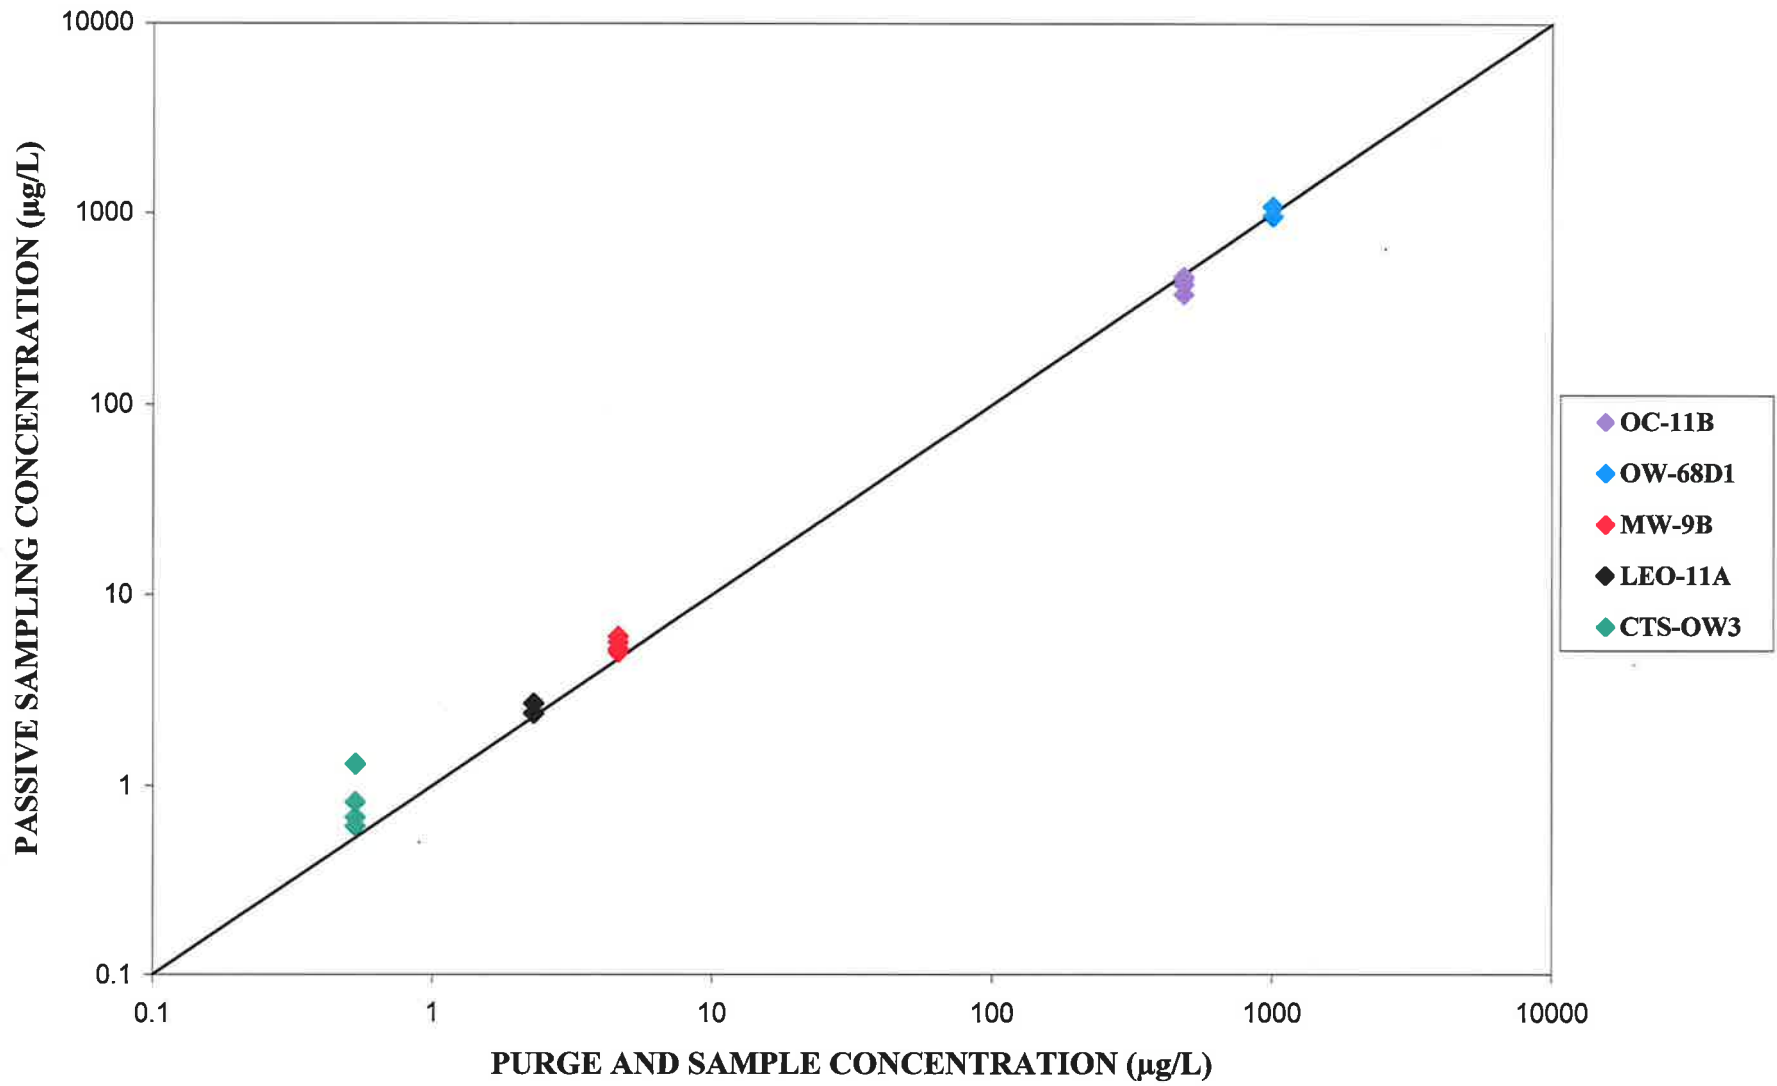


FIGURE 3-14
COMPARISON OF METHYLENE CHLORIDE CONCENTRATIONS



**FIGURE 3-13
COMPARISON OF CIS-1,2-DCE CONCENTRATIONS**

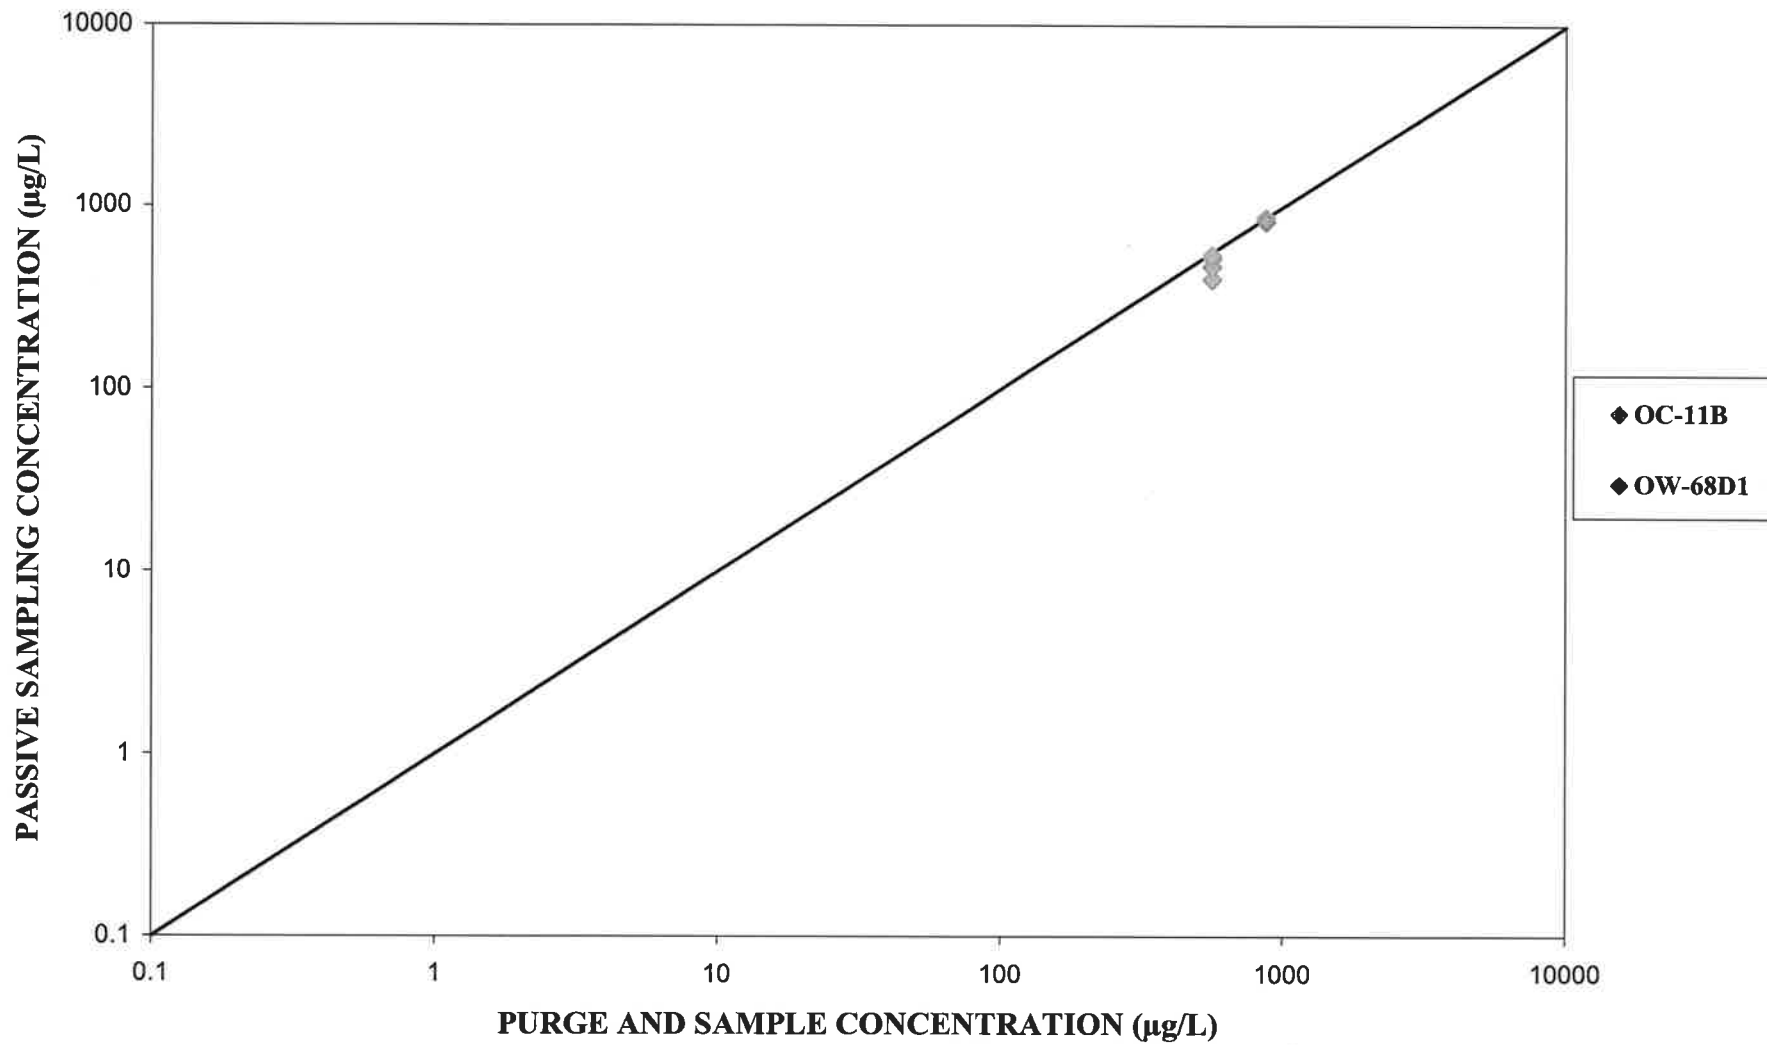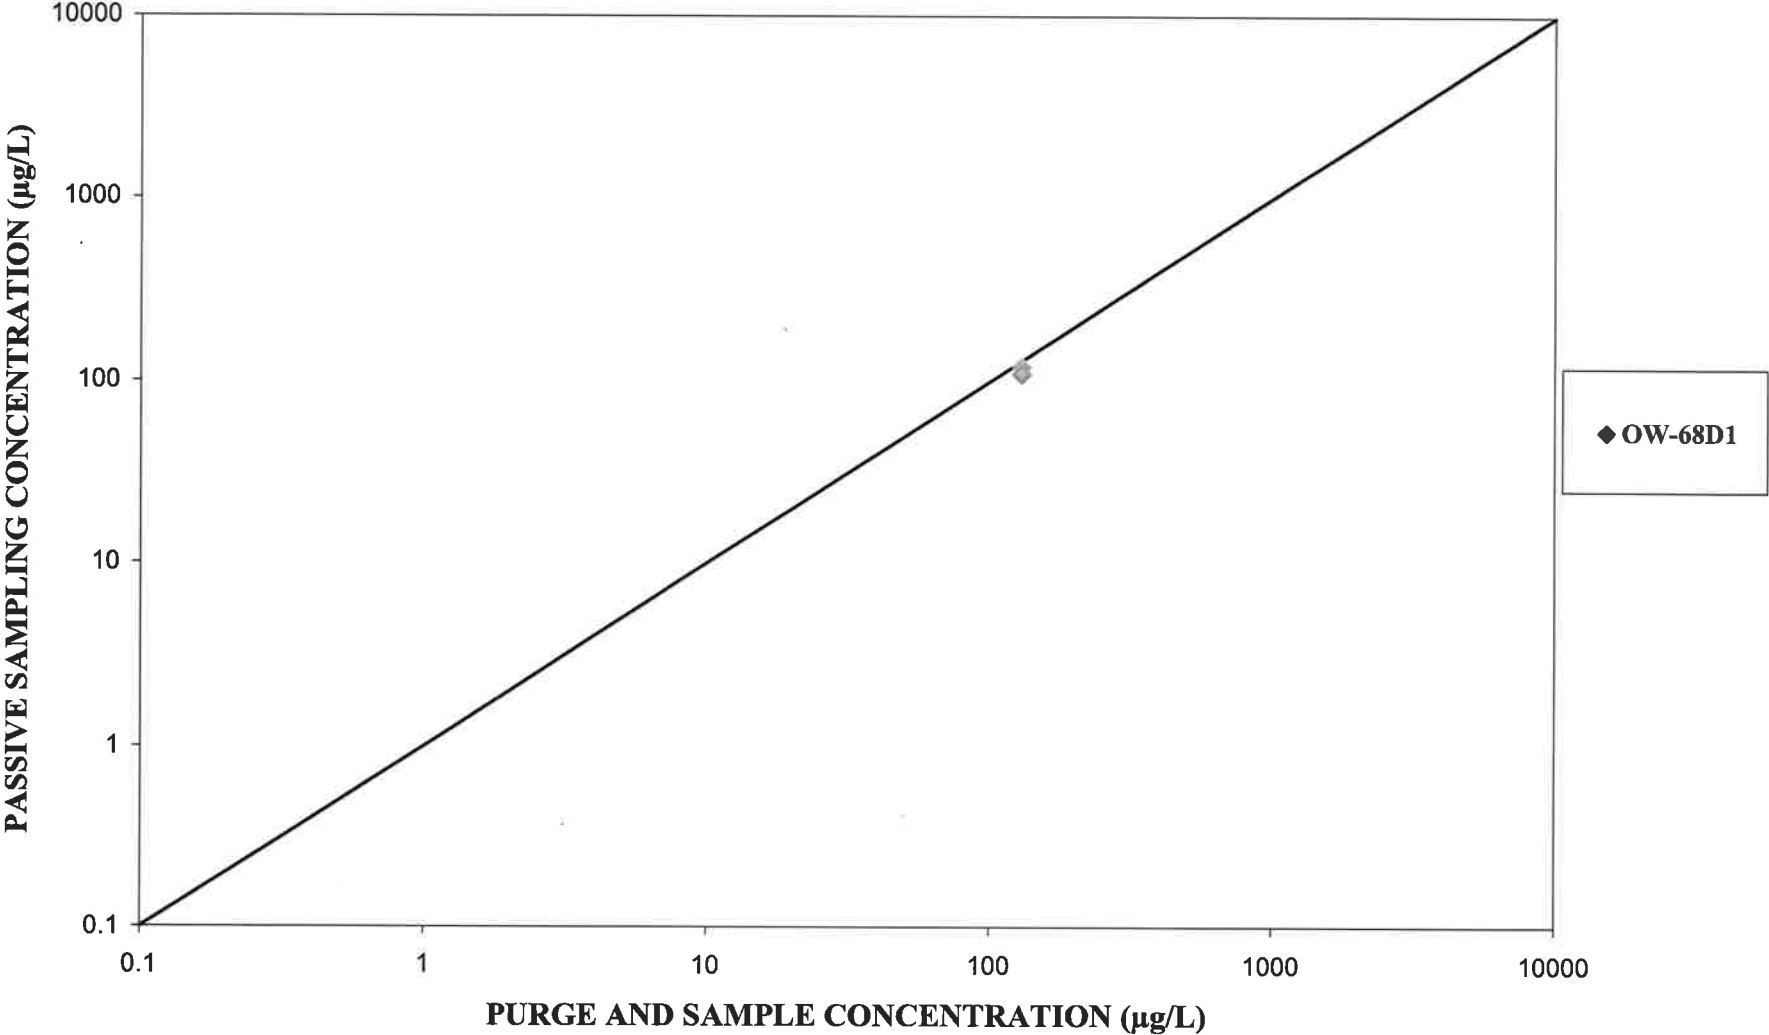

APPENDIX A
LITHOLOGIC LOGS



TETRA TECH BORING LOG

BORING I.D. NO. OW-68D2

CLIENT DTSC T.C. 10740-02 LOCATION Stringfellow DATE 12/27/89
 DRILL METHOD MUD ROTARY AUGER DIAMETER 2.4" FIELD GEOLOGIST Stephen Anderson

DEPTH (feet)	BLOW COUNT	OVA (ppm)	SAMPLE GRAPHIC COLUMN	USCS	GEOLOGIC DESCRIPTION
				GM	GRAVELLY SAND - Yellowish Brown (10YR 5/6), well graded fine-to coarse-grained sand with angular gravel, dry.
5		0.0			Gravelly sand as above.
10		0.0			Gravelly sand as above.
15		0.0			Gravelly sand as above.
20		0.0			Gravelly sand as above.
25		0.0		SM	SILTY SAND - Yellowish Brown (10YR 5/4), poorly graded fine grained sand with 20% silt. dry.
30		0.0			
35		N/R		GP	GRAVEL
				DGr	DECOMPOSED GRANITICS - Friable, crumbles to a coarse sand.
				Mls	METASEDIMENTS
40				DGr	

REVIEWING GEOLOGIST Stephen Anderson SIGNATURE Stephen Anderson REG. NO. 4591



TETRA TECH BORING LOG

BORING I.D. NO. OW-68D2

CLIENT DTSC T.C. 10740-02 LOCATION Stringfellow DATE 12/27/99

DRILL METHOD MUD ROTARY AUGER DIAMETER 2.4" FIELD GEOLOGIST Stephen Anderson

DEPTH (feet)	BLOW COUNT	DVA (ppm)	SAMPLE	GRAPHIC COLUMN	USCS	GEOLOGIC DESCRIPTION
					DB	
45		0.0				<u>DECOMPOSED GRANITICS</u> - (Granodiorite) fractures at 45 degrees from horizontal, mafics are mostly weathered and brown.
50		0.0	X			soft zone, possibly silt, lost recovery.
55		0.0	X			
		N/R				<u>DECOMPOSED GRANITICS</u> as above, soft zone, possibly silt, lost recovery.
60			X			
		N/R			Brd	end of highly weathered zone.
65		N/R				<u>GRANODIORITE</u> - 50% of core has weathered mafics that have turned brown.
		N/R				<u>GRANODIORITE</u> - Unweathered, possibly one horizontal fracture.
70			X			three horizontal fractures, some brown weathered mafics.
75						Total Depth = 72.8'. Borehole converted to monitoring well.
80						

REVIEWING GEOLOGIST Stephen Anderson


SIGNATURE Stephen Anderson

REG. NO. 4591



MONITORING WELL CONSTRUCTION SPECIFICATIONS

CLIENT: DTSC BORING WELL #: OW-68D1 DATE: 1/4/2000
 PROJECT #: 10740-02 GEOLOGIST: Stephen Anderson
 PROJECT NAME: Stringfellow SIGNATURE: Stephen Anderson
 COUNTY: Riverside REGISTRATION: #4591
 WELL PERMIT #: N/A
 DRILLING CONTRACTOR: Water Development Corporation

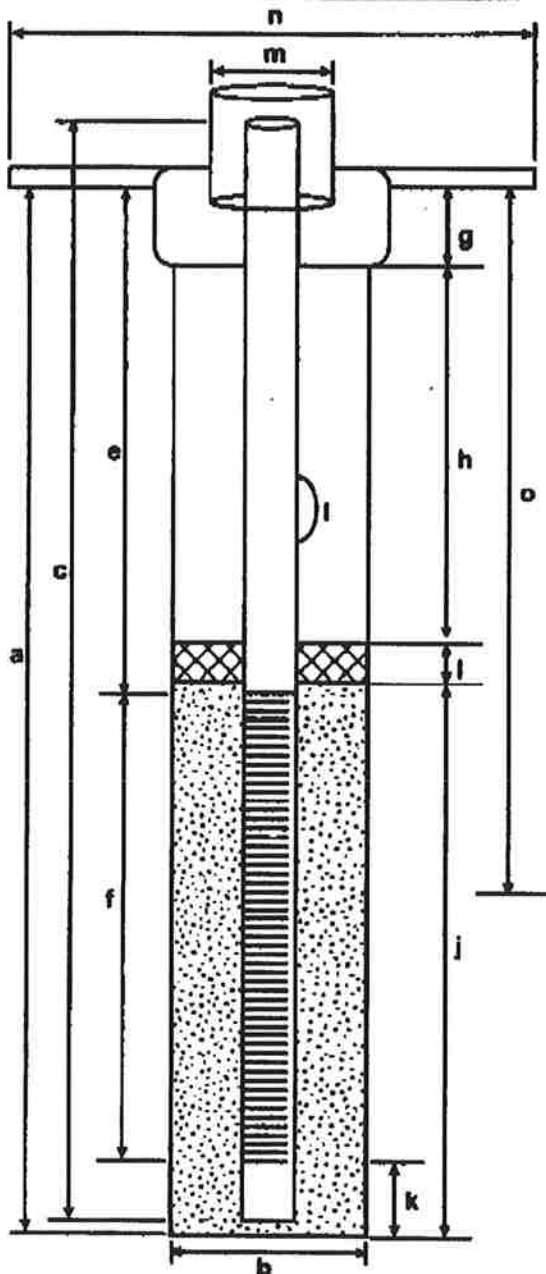

EXPLORATORY BORING

a. TOTAL DEPTH 59 ft.
 b. DIAMETER 10.625 in.
 DRILLING METHOD Mud Rotary

WELL CONSTRUCTION

c. TOTAL CASING LENGTH 61 ft.
 MATERIAL Schedule 40 PVC
 d. INSIDE DIAMETER 4 in.
 e. DEPTH TO TOP PERFORATIONS 41 ft.
 f. PERFORATED LENGTH 15 ft.
 PERFORATED INTERVAL FROM 41 to 56 ft.
 PERFORATION TYPE PVC Slotted
 PERFORATION SIZE .020 in.
 g. SURFACE SEAL 2 ft.
 SEAL MATERIAL Cement
 h. BACKFILL 33 ft.
 BACKFILL MATERIAL Cement/Quick Gel
 i. SEAL 3 ft.
 SEAL MATERIAL Bentonite
 j. GRAVEL PACK 21 ft.
 PACK MATERIAL Luna Lustre #3, Monterey sand
 k. SEDIMENT TRAP 3 ft.
 l. CENTRALIZERS 15, 36, 57 ft.
 m. WELL COVER DIAMETER 10.75 in.
 n. CONCRETE PAD DIAMETER 2 ft.
 THICKNESS 3.5 in.
 o. APPROXIMATE GROUND WATER DEPTH N/A ft.

SAMPLE TYPE SYMBOL	DEPTH	DESCRIPTION	COMMENTS
SS2	0-0.4'	lt yel br (10YR 6/4); fi sa, so si, tr med to co sa; lense; dry; SW-SM	BC: 10-29-9 Rec: 1.5' OVA: 2ppm (bkgd); bkgd (in jar)
"	0.4-1.5'	dk yel br (10YR 4/4) w/wh (5YR 8/1) mtl; fi sa, so si to al, tr med sa; compact; friable; dry; SW-SM-SC	← Bagolith OVA: 2.2ppm (in jar) ← Fill/alluvium
SS1	5-5.3'	dk yel br (10YR 4/4); si so fi to med sa, so cl; med compact; soft; v. sl damp; ML-MH	BC: 17-20-20 Rec: 1.45' OVA: bkgd (downhole and in jar)
"	5.3-6.5'	dk yel br (10YR 4/6) w/red yel (2.5YR 6/8) and wh (5YR 8/1) mtl; med sa, so si to al; compact; soft; granuly indurated; dry; SM-SC	OVA: bkgd (in jar)
SS3	10-10.9'	dk br (2.5YR 4/4); si, so cl, tr fi to med sa, tr co pb; compact; mod firm; damp; ML	BC: 11-16-20 Rec: 1.2' OVA: bkgd (downhole and in jar)
"	10.9-11.2'	dk br (2.5YR 7/4) w/pale yel (2.5YR 7/4) mtl; cl, so si, tr co pb; v compact; massive; tight; sl moist; CH	OVA: bkgd (in jar)
"	11.2-11.5'	strong br (2.5YR 4/4); fi sa, so si, so cl; compact; soft; damp; SM-SC	OVA: 3ppm (in jar)
SS4	15-15.1'	dk red br (5YR 3/3); cl, so si; dense; compact; damp; CL	BC: 17-17-17 Rec: 1.2' OVA: 35ppm (downhole); bkgd (in jar)
"	15.2-15.5'	dk yel br (10YR 3/6); si to fi sa, so cl, tr med sa; compact; mod firm; dry; ML-SC	OVA: 4ppm (in jar)
PT	17-19.5'	dk br (10YR 3/3) w/dk gr (10YR 4/1), blk (10YR 2/1) and yel red (5YR 5/6) mtl; fi sa to v fi pb, so si, tr cl, tr med pb (granularitic); compact; mod firm; brittle; damp; SP	Pulldown: 175-275 lbs; Rec: 1.0'
SS5	20-20.5'	dk yel br (10YR 3/6); si, so cl, so fi sa; compact; firm; v damp; ML	BC: 13-43-25 Rec: 0.9' OVA: 11ppm (downhole); 6.5ppm (in jar)
"	20.5-21.5'	dk yel br (10YR 3/4) to gr (10YR 6/1); si to fi sa, tr cl, r sb (pt to 20.5-20.7' sec); compact; firm; sl moist; ML-SM	OVA: 13ppm (in jar)
SS6	25-26.5'	dk br (10YR 3/3) w/v dk gr br (10YR 3/2) mtl; fi sa to si, tr cl, tr co sa; compact; med cohesive; sl moist; SM-MH	BC: 13-18-17 Rec: 1.35' OVA: 40ppm (downhole); 7ppm (in jar) ← decomposed gd contact
	27.3'		BC: 50 Rec: 0
SS7	28'		OVA: 60ppm (downhole)

CLIENT California DHS
LOCATION Stringfellow
PROJECT No. 078-65



SAI by C. Kruger
SHEET 1 of 2
BORING No. 0C-11

LITHOLOGIC LOGS (Continued)

Well No.	Depth Interval (Feet)	Description
MW-7B	0-30	<u>SAND</u> - dk brn (dry); silt to fine pebble gravel, predom. med. sand; mod. sorted
	30-40	<u>SAND</u> - brn (dry); clay to granule gravel, predom. v. fine sand; mod. sorted
	40-60	<u>SAND and CLAY</u> - brn (dry); clay to v. coarse sand, predom. silt to v. fine sand; well sorted
	60-80	<u>SAND</u> - brn (dry); clay to fine pebble gravel, predom. v. fine sand, mod. sorted
	80-100	<u>SAND with GRAVEL</u> - brn (dry); silt to med. pebble gravel, predom. fine sand; poorly sorted (grains are angular and show hematite staining)
MW-8B	0-20	<u>SAND</u> - brn (dry); v. fine sand to med. pebble gravel (rare); predom. fine sand; mod. to well sorted
	20-40	<u>SAND</u> - brn (dry); clay to med. pebble gravel, predom. fine sand; mod. sorted
	40-80	<u>SAND</u> - brn (dry); clay to granule gravel, predom. v. fine to fine sand; mod. sorted; increasing clay content with depth.
	80-100	<u>SAND with CLAY</u> - brn (dry); clay to granule gravel, predom. fine sand; well sorted
MW-9B	0-30	<u>SAND</u> - brn (dry); silt to fine pebble gravel, predom. fine sand; well sorted
	30-60	<u>SAND</u> - brn (dry); clay to med. pebble gravel, predom. v. fine sand; mod. sorted
	60-85	<u>SAND and GRAVEL</u> - brn (dry); v. fine sand to med. pebble gravel, predom. v. coarse sand to fine pebble gravel; hematite staining
	85-110	<u>SAND and GRAVEL</u> - brn (dry); med. sand to fine pebble gravel, predom. v. coarse sand to granule gravel; extensive hematite staining

"Screen"
16" - 100'

} decomposed
rock?

"Screen"
0' - 100'

"Screen"
0' - 100'
WIDE - 2-5" DIA

↓
decomposed
Rock

TX 1124544

LO602.335A

LE011A

GEOLOGIC DRILL LOG		PROJECT Stringfellow Hazardous Waste Site		JOB NO. 19742	SHEET NO. 1 OF 3	HOLE NO. LE011A
SITE Lower Canyon		COORDINATES N ; E		ANGLE Vertical		BEARING -----
BEGUN 4-4-89	COMPLETED 4-5-89	DRILLER Datum Exploration	DRILL MAKE CME-75	SIZE 8.25"	OVERBURDEN (FT) 63.0	ROCK (FT) 2.0
CORE RECOVERY /		CORE BOX 13	TOP CASING /	GROUND EL. 50.0	GROUND WATER 4-5-89	TOP OF ROCK 63.0
HAMMER WEIGHT/FALL 140 lbs. / 30 in.		CASING LEFT IN HOLE		LOGGED BY: G. A. Day		

SAMP. TYPE	SAMP. ADJ. LEN. CORE	RECOVERY	SAMPLE BLOWS % CORE RECOVERY	WATER PRESSURE TESTS			DEPTH GRAPHICS	SAMPLE	DESCRIPTION AND CLASSIFICATION	NOTES ON: WATER LEVELS, WATER RETURN, CHARACTER OF DRILLING, ETC.
				LOSS	G.P.M.	THICK. M.				
									0-63.0 ft. SILTY SAND (SM) Dark Yellowish Brown (10YR 4/2) to Moderate Brown (5YR 4/4) silt and fine to medium grained sand with minor amounts of coarse grained sand. Dry, loose density, poorly sorted, subrounded to angular. Predominately quartz, feldspar, and biotite. Grains tend to be moderately to highly weathered. Traces of clay and angular to subangular gravels and cobbles throughout interval.	Advanced borehole with 4-1/4" hollow stem augers 0-65.0 ft.
SS	1.5	1.5	7-6-9				5			
SS	1.5	1.5	7-9-10				10			Sampled with 2" split spoon 0-65 ft. at 5 ft. intervals.
SS	1.5	1.5	5-5-7				15			
SS	1.5	1.5	5-11-13				20			Encountered decomposed granite "OG" at a depth of 63.0 ft.
SS	1.5	1.0	30-50/5"				25			
SS	1.5	1.0	15-50/5"				30			

NO EXCEPTION NOTED
 REJECTED
 MAKE CORRECTIONS NOTED
 REVISE AND RESUBMIT
 SUBMIT SPECIFIED ITEM

CHECKING IS ONLY FOR GENERAL CONFORMANCE WITH THE DESIGN CONCEPT OF THE PROJECT AND GENERAL COMPLIANCE WITH THE INFORMATION GIVEN IN THE CONTRACT DOCUMENTS. ANY ACTION SHOULD BE SUBJECT TO THE REQUIREMENTS OF THE PLANS AND SPECIFICATIONS. CONTRACTOR SHALL BE RESPONSIBLE FOR DIMENSIONS WHICH SHALL BE CONFIRMED AT THE JOB SITE; FABRICATION PROCESSES OF CONSTRUCTION; COORDINATION OF HIS WORK WITH THAT OF ALL OTHER TRADES; AND THE SATISFACTORY COMPLETION OF HIS WORK.

SS=SPLIT SPOON; ST=SHELBY TUBE
 O=DENNISON; P=PITCHER; Q=OTHER

SITE: Lower Canyon
 BY: *Timothy A. Margham*
 DATE: *4/16/89*


CH2M HILL, INC.
 ENGINEERS PLANNERS ECONOMISTS SCIENTISTS
 2519 RED HILL AVE., SUITE A
 SANTA ANA, CA 92705

TX 1124710

TX0815402



LE011A

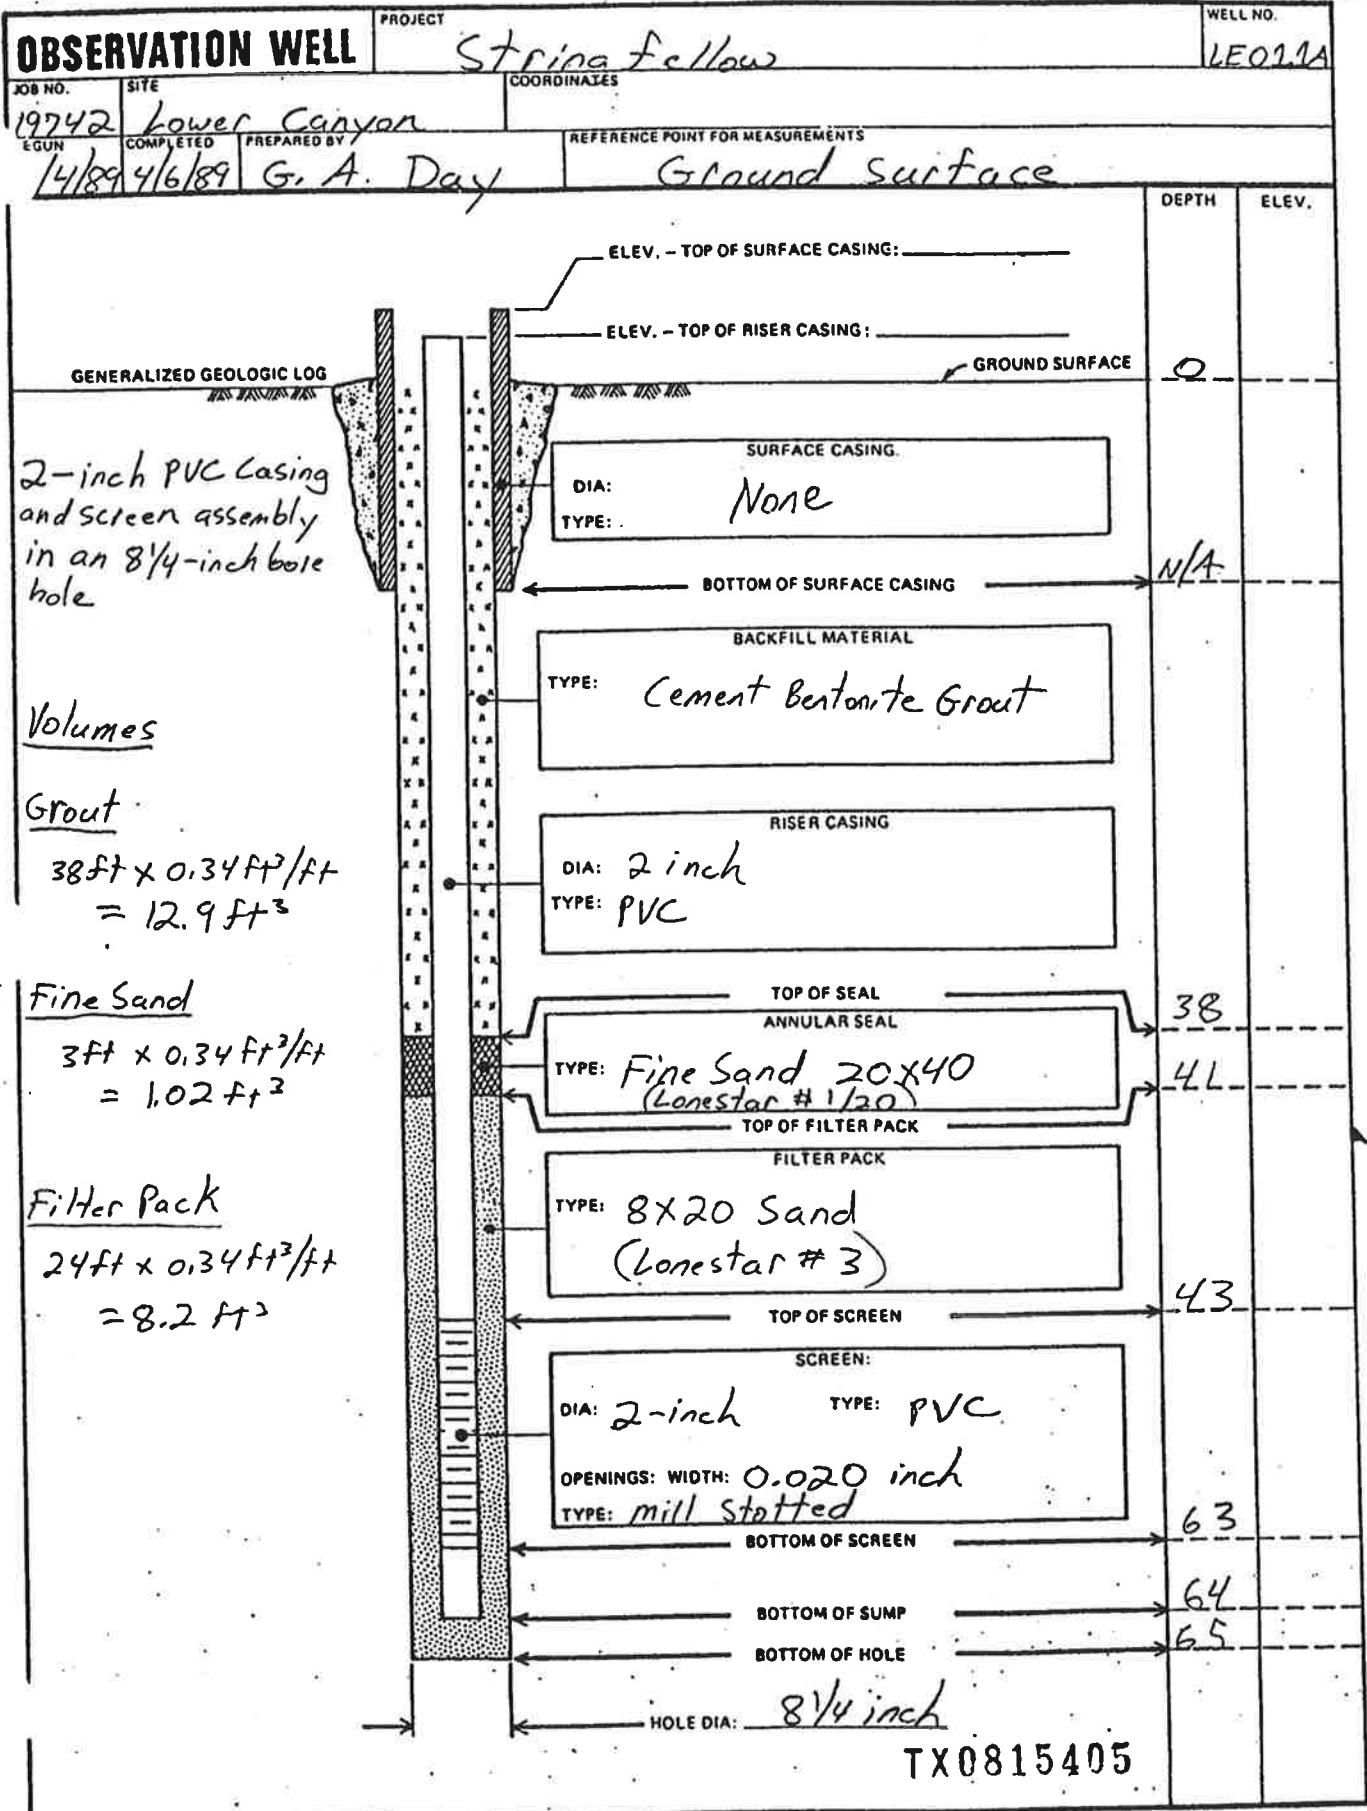

Volumes

Grout

$$38\text{ft} \times 0.34\text{ft}^3/\text{ft} = 12.9\text{ft}^3$$

Fine Sand

$$3\text{ft} \times 0.34\text{ft}^3/\text{ft} = 1.02\text{ft}^3$$

Filter Pack

$$24\text{ft} \times 0.34\text{ft}^3/\text{ft} = 8.2\text{ft}^3$$

TX0815405

GEOLOGIC DRILL LOG				PROJECT		JOB NO.	SHEET NO.	HOLE NO.		
				Stringfellow Hazardous Waste Site		19742	2 OF 3	LE011A		
SAMP. TYPE	SAMP. AD. LEN. CORE	RECOVERY	SAMPLE BLOWS % CORE RECOVERY	WATER PRESSURE TESTS		DEPTH	GRAPHICS	DESCRIPTION AND CLASSIFICATION	NOTES ON: WATER LEVELS, WATER RETURN, CHARACTER OF DRILLING, ETC.	
				LOSS IN G.P.M.	P.S.F.					
					TIME MIN.					
SS	1.5	1.5	20-21-50			35		35-55 ft. <u>SILTY GRAVELS-SILTY SANDS</u> (GM-SM) Gravel and cobbles angular to subangular, moderately weathered, intermixed with silts and fine to medium grained sands. Includes angular pieces of feldspar, quartz, biotite, and severely weathered decomposed granite. Also traces of clays within matrix. 45 ft. Silty gravelly sand becomes slightly moist. 50 ft. Silty gravelly sand becomes wet to saturated.	cuttings. Color descriptions from the GSA Rock Color Chart (1948). Installed 2" alluvium observation well 4- -89.	
SS	1.5	1.5	21-30-50			40				
SS	1.5	1.0	22-50/5"			45				
SS	1.5	0.6	30-50/3"			50				
SS	1.5	1.5	13-9-10			55				
SS	1.5	1.0	20-50/5"			60				
SS	0.5	0.5	10-60/4"			65				
								60s	55-63.0 ft. Silty Sand (SM) Moderate Brown (5YR 3/4) fine sand and silt with minor amounts of medium to coarse sand and gravel and traces of clay. Coarse sand to gravel sized pieces of DG, moderately to severely weathered, rock fabric intact, severe loss of strength. 60 ft. Abundant decomposed granite pockets.	
									63.0-65.0 ft. <u>DECOMPOSED GRANITE</u> Dark Yellowish Orange (10YR 6/6) and Grayish Orange (10YR 7/4), abundant discoloration of minerals (i.e. feldspars	

SS=SPLIT SPOON; ST=SHELBY TUBE
D=DENNISON; P=PITCHER; O=OTHER

SITE

Lower Canyon

HOLE NO.

LE011A

TX 1124711

TX0815403

LE011A

GEOLOGIC DRILL LOG				PROJECT Stringfellow Hazardous Waste Site		JOB NO. 19742	SHEET NO. 3 OF 3	HOLE NO. LE011A		
SAMP. TYPE	SAMP. AD. LEN. CORE	RECOVERY	SAMPLE BLOWS % CORE RECOVERY	WATER PRESSURE TESTS		DEPTH	GRAPHICS	SAMPLE	DESCRIPTION AND CLASSIFICATION	NOTES ON: WATER LEVELS, WATER RETURN, CHARACTER OF DRILLING, ETC.
				LOSS G. IN	PRESS. P.S.F.					
									altering to clay minerals), gravel-cobble sized fragments of granite intermixed with silt and fine to medium grained sand. Predominate minerals include quartz, feldspar, and biotite. Very severely weathered, rock fabric discernible, soft to medium hard.	
									Bottom of Hole 65.0 ft.	

SS=SPLIT SPOON; ST=SHELBY TUBE
D=DENNISON; P=PITCHER; O=OTHER

SITE
Lower Canyon

HOLE NO.
LE011A

TX 1124712

TX0815404

Bechtel GEOLOGIC DRILL LOG				PROJECT	JOB NO.	SHEET NO.	HOLE NO.
Community South				Stringfellow	21106	1 OF 2	CTS-OW3
SITE		COORDINATES			ANGLE FROM NORTH		BEARING
Community South		N 670815.45; E 1631961.17			Vertical		-----
BEGIN	COMPLETED	DRILLER	DRILL MAKE AND MODEL	SIZE	OVERBURDEN	ROCK (FT.)	TOTAL DEPTH
11-7-90	11-8-90	Klyde Chivrell	Speedstar SS15	6-inch	81.0	2.0	83.0
CORE RECOVERY (FT./%)		CORE BOXES	SAMPLES	SEL. TOP CASING	GROUND EL.	DEPTH/EL. GROUND WATER	DEPTH/EL. TOP OF ROCK
/					773.55	19.0/754.6	81.0/692.5
SAMPLE HAMMER WEIGHT/FALL		CASING LEFT IN HOLE: DIA./LENGTH			LOGGED BY:		
		See obs. well log			Pete West		
SOIL TYPE	SOIL DIA.	SOIL QTY. LEN. CORE	SOIL REC. CORE REC.	SOIL IN-RECOVERY	LOSS G.P.M.	WATER PRESSURE TESTS	TIME MIN.
(Template= BCHTLLS)							
ELEV.		DEPTH	GRAPHICS	DESCRIPTION AND CLASSIFICATION			NOTES ON: WATER LEVELS, WATER RETURN, CHARACTER OF DRILLING, ETC.
773.6				0 - 5 ft. <u>FILL</u> : Fill, silt, sand, gravel.			Drilled with casing hammer Rig with 7/8-inch bit and 6-inch Drive casing. Geologic description based on drill cuttings.
768.6	5			5 - 10 ft. <u>SILTY SAND (SM)</u> : Grayish-red (10R 4/3), fine-grained, angular.			
763.6	10			10 - 15 ft. <u>SILTY SAND (SM)</u> : Dusky red (5R 3/4), fine-grained, angular.			
758.6	15			15 - 25 ft. <u>SILTY SAND (SM)</u> : Dark reddish-brown (10R 3/4), medium-to coarse-grained.			
	20			From 25-30 ft., finer-grained.			
	25						
	30						
738.6	35			35 - 40 ft. <u>SAND (SP)</u> : Grayish-red (5R 4/2), coarse-grained, angular and small gravel, trace silt.			
733.6	40			40 - 45 ft. <u>SILTY SAND (SM)</u> : Moderate red (5R 4/6), very fine-grained.			
	45			From 45-50 ft., trace sand.			
	50						
	55						
718.6	55			55 - 60 ft. <u>SAND (SP)</u> : Grayish-red (5R 4/2), medium-to coarse-grained, angular, dirty, some gravel.			
713.6	60			60 - 73 ft. <u>SILTY SAND (SM)</u> : Dark reddish-brown (10R 3/4), very fine-grained.			
	65						
SS = SPLIT SPOON; CA = CALIFORNIA; D = DENNISON; P = PITCHER; O = OTHER							SITE Community South
Last Update: 2-20-91							HOLE NO. CTS-OW3

TX 1124990

Bechtel GEOLOGIC DRILL LOG

PROJECT

Stringfellow

JOB NO.
21106

SHEET NO.
2 OF 2

HOLE NO.
CTS-OW3

SAMP. DIA.	SAMP. ADV. LEN. CORE	SAMP. REC. CORE REC.	SAMP. BLOKS "N" CORE RECOVERY	LOSS IN G.P.M.	WATER PRESSURE P.S.I.	TIME MIN.	ELEV.	DEPTH	GRAPHICS	DESCRIPTION AND CLASSIFICATION	NOTES ON: WATER LEVELS, WATER RETURN, CHARACTER OF DRILLING, ETC.
							700.6				
								75	[Stippled Pattern]	73 - 81 R. SAND (SP): Grayish-red (5R 4/4), medium-to coarse-grained, angular, dirty, with some small gravel.	
							692.6	80	[Cross-hatched Pattern]	81 - 83 R. DECOMPOSED GRANITE: Moderate brown (5YK 3/4), medium-to coarse-grained, friable.	
							690.6			BOTTOM OF HOLE : 83.0 FT.	


TX 1124991

SS = SPLIT SPOON; ST = SHELBY TUBE; D = DENNISON; P = PITCHER; O = OTHER

SITE
Community South

Last Update: 2-20-91 HOLE NO. **CTS-OW3**

Bechtel		PROJECT	WELL NO.
MONITORING WELL		Stringfellow	CTS-OW3
WELL NO.	SITE	COORDINATES	
21106	Community South	N 670,815.5 E 1,631,961.2	
BEGUN	COMPLETED	PREPARED BY	REFERENCE POINT FOR MEASUREMENTS
11-7-90	11-8-90	Pete West	Top of 2-inch PVC

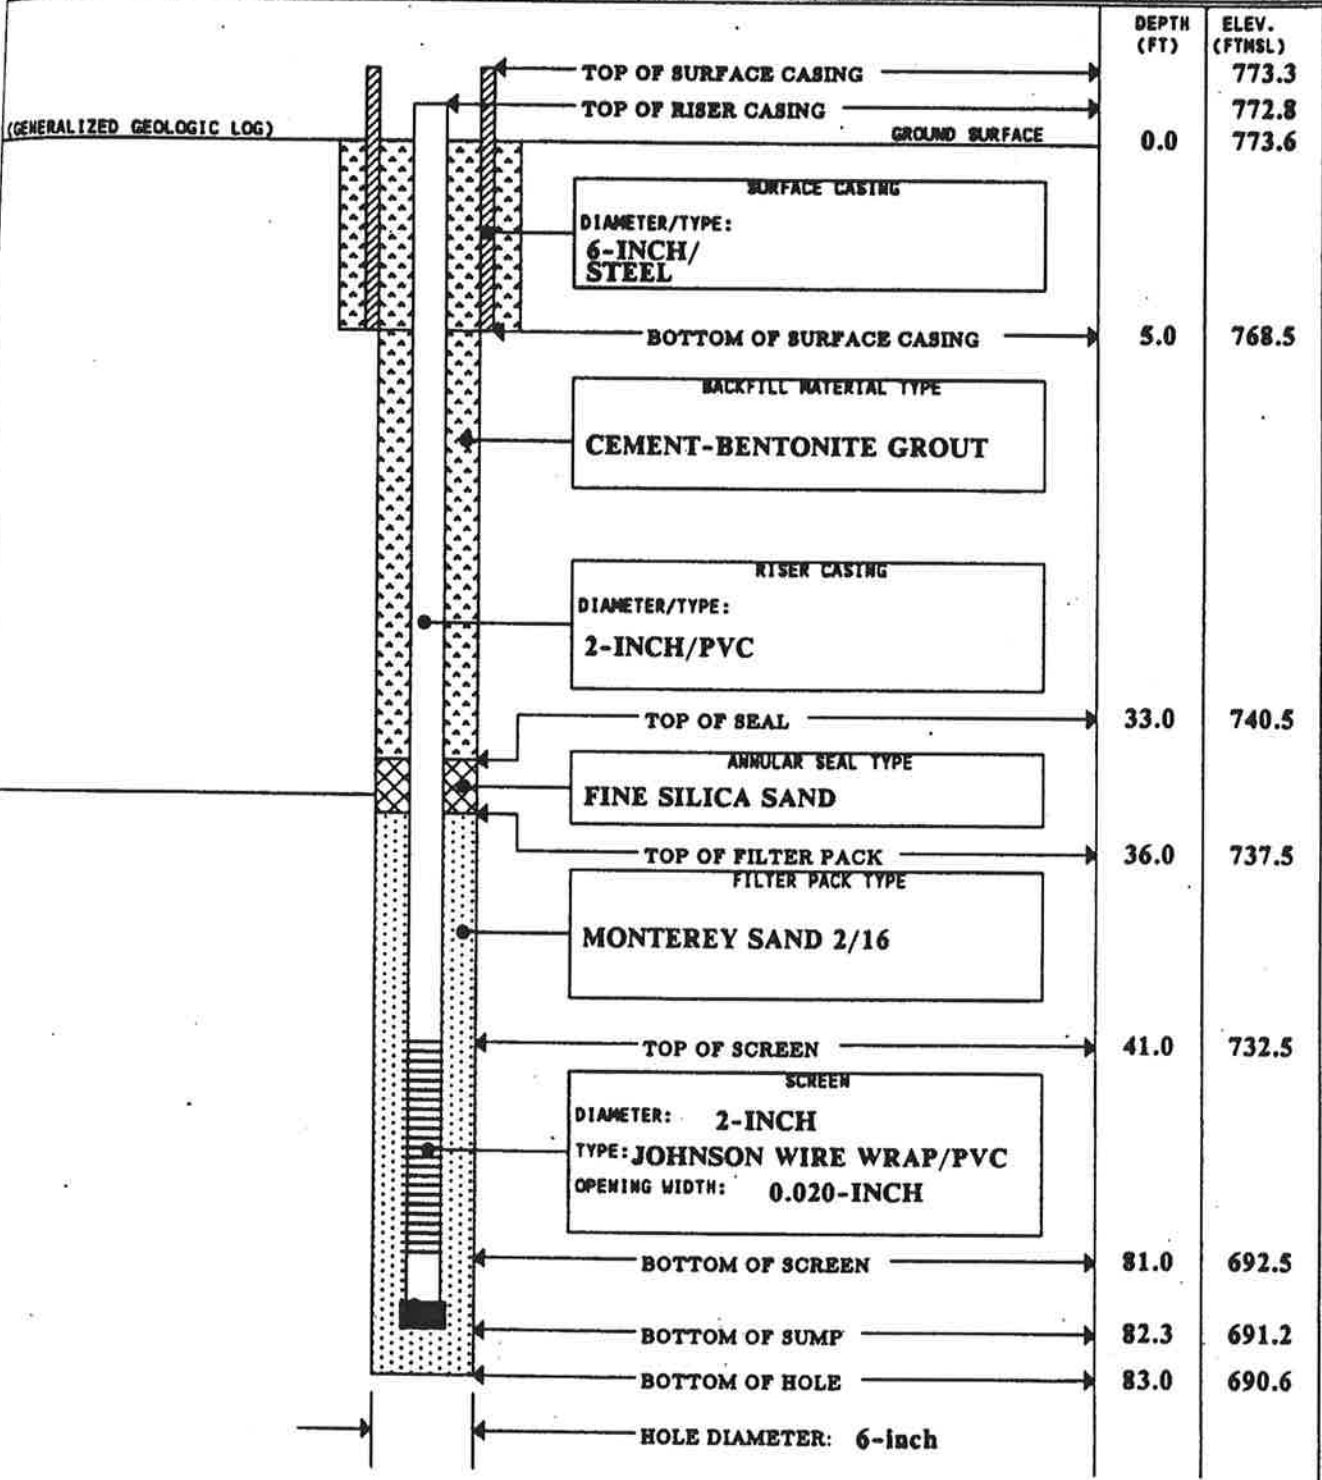

TX 1124992

Last Update: 2/19/91 (Template:LASERMON)

SB/MW#: FC1020A
 #D- 19030-32
 Page 1 of 2
 Sampler: Todd Overturf

SOIL DRILLING LOG

PROJECT Pyrite Canyon LOCATION 4930 Agate Street, Glen Avon, CA
 ELEVATION 735.2 feet MSL MONITORING DEVICE Hnu PI 101
 SAMPLING DATE(S) 9-23-97 START 9:00 AM FINISH 4:30 PM
 SAMPLING METHOD CA MOD SPLIT SPOON SUBCONTRACTOR & EQUIPMENT Bevlik Drilling CME 75
 EMO (5.40,50.5) = Gravel, sand, silt, and clay percentages respectively.

Penetration Results		Sampler Depth Interval (ft.)	Sample ID #	Hnu Reading (ppm)	Soil Description Color, Texture, Moisture, Etc.	Unified Class.	Graphic Log	Sample Depth	Borehole Abandonment/ Well Construction Details
Blows 6"-6'-6"	BPF								
				0.0	Grass surface.	SM		Locking Cap	
19-28-30	58	5.0 6.5	FC-3S-5	0	@5' Silty sand: (10,70,20,0); yellowish brown (10YR 5/4); coarse to very coarse sand; angular to subangular; poorly graded; medium dense; dry.				4" Sch 40 PVC Blank Casing 10" Diameter Borehole Bentonite Grout
29-32-39	71	10.0 11.5	FC-3S-10	0	10.0 Sandy silt: (0,10,85,5); dark yellowish brown (10YR 4/4); fine sand; poorly graded; medium dense; mottled coloration; moist.	ML			Bentonite Pellets
42-43-50	93	15.0 16.5	FC-3S-15	0	@15' As above, color change to olive brown (2.5Y 4/3).				#3 Lonestar Sand
16-18-24	42	20.0 21.5	FC-3S-20	0	@20' Sandy silt: (2,48,48,2); dark yellowish brown (10YR 4/4); medium dense; very fine to fine sand; gravel is angular; wet.				4" Sch 40 0.02" Slotted PVC Screen 13-60
12-44-31	75	25.0 26.5	FC-3S-25	0	@25' As above.				
22-39-46	85	30.0 31.5	FC-3S-30	0	@30' Sandy silt: (0,30,60,10); dark yellowish brown (10YR 4/4); fine sand; poorly graded; medium dense;				
				35.0					

Continued Next Page

TX_2049254

SOIL DRILLING LOG

PROJECT Pyrite Canyon LOCATION 4930 Agate Street, Glen Avon, CA

Depth Below Surface (ft.)	Penetration Results		Sampler Depth Interval (ft.)	Sample ID #	Hru Reading (ppm)	Soil Description Color, Texture, Moisture, Etc.	Unified Class.	Graphic Log	Sample Depth	Borehole Abandonment/ Well Construction Details
	Blows 6"-6"-6"	BPF								
37-50	87	35.0	FC-3S-35	0	micaceous; saturated.	SM				
40	24-42-50	92	40.0	FC-3S-40	0	✓ Silty sand: (0,90,10,0); dark yellowish brown (10YR 4/4); medium graded; medium to coarse sand; subangular; dense; saturated.	ML/SM			
45	42-76	118	45.0	FC-3S-45	0	Sand and silt: (2,50,48,0); dark yellowish brown (10YR 4/4); medium dense; poorly graded; very fine to fine sand; saturated. @45' as above.				4" Sch 40 0.02" Slotted PVC Screen
50	43-90	133	50.0	FC-3S-50	0	✓ @50' Silty sand: (0,80,20,0); dark yellowish brown (10YR 4/3); medium to coarse; subangular; poorly graded; very dense; saturated.				
55	60-118	178	55.0	FC-3S-55	0	@53' Hard drilling.	DG			
60	64-100	164	60.0	FC-3S-60	0	Highly weathered granitic rock: 50% plasioclase; 30% quartz; 10% k-feldspar; 10% hornblende and augite; hornblende weathered to mica; minor iron staining. @60' As above.				PVC Cap T.D. = 60'
65										
70										
75										

APPENDIX B
FIELD DATA SHEETS



BRYAN A. STIRRAT & ASSOCIATES

GROUNDWATER MONITORING PROGRAM WELL DATA SHEET

SITE: Stringfellow

Well No.	<u>CTS-0W3</u>	Sampling Date:	<u>4-21-08</u>
Collected By:	<u>HS</u>	Purge Start Time:	<u>1710</u>
Casing Diameter (inches):	<u>2</u>	Purge Stop Time:	<u>1721</u>
Starting Water Level (feet):	<u>25.47</u>	Sampling Time:	<u>1730</u>
Total Depth (feet):	<u>81.10</u>	Ending Water Level (feet):	<u>25.48</u>
Water Column (feet):	<u>55.63</u>	Total Purged (gallons):	<u>28</u>
Screen Length (feet):	<u>N/A</u>	<input checked="" type="checkbox"/> FID Reading	<u>N/A</u>
Purge Volume (gallons):	<u>2780</u>	Duplicate Sample	Yes <input type="checkbox"/> No <input checked="" type="checkbox"/>
Horiba Model S/N:	<u>303029</u>		

Gallons Purged	Water Level	pH	Conductivity ms/cm	Turbidity NTU	D.O. mg/L	Temperature °C	ORP MV
5	—	6.8	1.37	113.0	5.3	22.7	67
10	—	6.8	1.37	60.9	5.3	22.6	104
15	—	6.7	1.38	57.4	5.2	22.6	111
20	—	6.7	1.38	54.0	5.2	22.6	119
25	—	6.7	1.38	50.4	5.2	22.6	126
28	—	6.7	1.38	48.8	5.2	22.6	130

Purging Sampling Rates 2.5 G.P.M. Purged @ 285 ft. Flow approx 2

Well Condition: OK. water looks little cloudy, no odor.

Additional Information/Comments: clear, warm, light winds

Zemsky



BRYAN A. STIRRAT & ASSOCIATES

GROUNDWATER MONITORING PROGRAM WELL DATA SHEET

SITE: Stringfellow

Well No.	<u>OW-68D1</u>	Sampling Date:	<u>4-24-08</u>
Collected By:	<u>RR</u>	Purge Start Time:	<u>/</u>
Casing Diameter (inches):	<u>4"</u>	Purge Stop Time:	<u>/</u>
Starting Water Level (feet):	<u>51.31</u>	Sampling Time:	<u>1755</u>
Total Depth (feet):	<u>59.00</u>	Ending Water Level (feet):	<u>/</u>
Water Column (feet):	<u>7.69</u>	Total Purged (gallons):	<u>/</u>
Screen Length (feet):	<u>—</u>	PID/FID Reading	<u>0</u>
Purge Volume (gallons):	<u>0</u>	Duplicate Sample	Yes <input type="checkbox"/> No <input checked="" type="checkbox"/>
Horiba Model S/N:	<u>303046</u>		

Gallons Purged	Water Level	pH	Conductivity ms/cm	Turbidity NTU	D.O. mg/L	Temperature °C	ORP MV
grab		3.0	12.3	46	—	23.4	259

Purging Sampling Rates sample taken with a disp. bailer

Well Condition: OK

Additional Information/Comments: water dark red with strong odor. Lab to FILTER FOR METALS. Provided extra 1L container. zone-1b.



BRYAN A. STIRRAT & ASSOCIATES

GROUNDWATER MONITORING PROGRAM WELL DATA SHEET

SITE: Stringfellow

Well No.	<u>MW-9B</u>	Sampling Date:	<u>4-28-08</u>
Collected By:	<u>BO-JG</u>	Purge Start Time:	<u>1433</u>
Casing Diameter (inches):	<u>2"</u>	Purge Stop Time:	<u>1443</u>
Starting Water Level (feet):	<u>49.61</u>	Sampling Time:	<u>1448</u>
Total Depth (feet):	<u>100.00</u>	Ending Water Level (feet):	<u>50.35</u>
Water Column (feet):	<u>50.39</u>	Total Purged (gallons):	<u>16</u>
Screen Length (feet):	<u> </u>	PID/FID Reading	<u> </u>
Purge Volume (gallons):	<u>16.42</u>	Duplicate Sample	Yes <input type="checkbox"/> No <input checked="" type="checkbox"/>
Horiba Model S/N:	<u>302030</u>		

Gallons Purged	Water Level	pH	Conductivity ms/cm	Turbidity NTU	D.O. mg/L	Temperature °C	ORP MV
4	—	6.9	0.578	237.0	8.5	24.1	182
8	—	6.6	0.548	179.0	6.2	23.9	177
12	—	6.5	0.581	165.0	4.4	23.9	174
16	—	6.5	0.580	148.0	3.7	23.8	172

Purging Sampling Rates PURGED WELL @ 300 HZ FLOW @
APPROX 2 GPM

Well Condition: OK, WATER TURBID W/NO ODDOR

Additional Information/Comments: SUNNY, HOT LIGHT BREEZE

*CHECK PH WITH PH STRIP.



BRYAN A. STIRRAT & ASSOCIATES

GROUNDWATER MONITORING PROGRAM WELL DATA SHEET

SITE: Stringfellow

Well No.	<u>LEO-11A</u>	Sampling Date:	<u>4-26-08</u>
Collected By:	<u>PJO, BJS</u>	Purge Start Time:	<u>0940</u>
Casing Diameter (inches):	<u>2</u>	Purge Stop Time:	<u>0949</u>
Starting Water Level (feet):	<u>55.09</u>	Sampling Time:	<u>1000</u>
Total Depth (feet):	<u>65.10</u>	Ending Water Level (feet):	<u>55.18</u>
Water Column (feet):	<u>10.01</u>	Total Purged (gallons):	<u>5</u>
Screen Length (feet):	<u>—</u>	PID/FID Reading	<u>—</u>
Purge Volume (gallons):	<u>4.89</u>	Duplicate Sample	Yes <input type="checkbox"/> No <input checked="" type="checkbox"/>
Horiba Model S/N:	<u>MP-20</u>		

Gallons Purged	Water Level	pH	Conductivity ms/cm	Turbidity NTU	D.O. mg/L	Temperature °C	ORP MV
1		6.69	174	675	—	22.82	156
2		6.65	175	758	—	22.74	157
3		6.62	175	421	—	22.61	160
5		6.69	175	641	—	22.78	165

Purging Sampling Rates Hand bailed well with new 1 1/2" disposable bailer. cloudy water & sediments

Well Condition: OK - rope & weight inside well, pulled out labeled & placed in a new ziplock bag, & set in Carol Wilson's desk

Additional Information/Comments: Carl-3



BRYAN A. STIRRAT & ASSOCIATES

GROUNDWATER MONITORING PROGRAM WELL DATA SHEET

SITE: Stringfellow

Well No.	<u>FC-1020A</u>	Sampling Date:	<u>4-23-08</u>
Collected By:	<u>B.S. (B.S.O. MA)</u>	Purge Start Time:	<u>0830</u>
Casing Diameter (inches):	<u>4</u>	Purge Stop Time:	<u>0850</u>
Starting Water Level (feet):	<u>14.74</u>	Sampling Time:	<u>0855</u>
Total Depth (feet):	<u>60.00</u>	Ending Water Level (feet):	<u>14.79</u>
Water Column (feet):	<u>45.26</u>	Total Purged (gallons):	<u>60</u>
Screen Length (feet):	<u> </u>	PID/FID Reading	<u> </u>
Purge Volume (gallons):	<u>59.10</u>	Duplicate Sample	<input checked="" type="checkbox"/> Yes <input type="checkbox"/> No
Horiba Model S/N:	<u>9108</u>		

Gallons Purged	Water Level	pH	Conductivity ms/cm	Turbidity NTU	D.O. mg/L	Temperature °C	ORP MV
15		7.0	1.20	7.5	5.7	22.0	495
30		7.0	1.21	7.1	4.0	22.1	486
45		7.1	1.21	1.1	3.8	22.2	481
60		7.3	1.21	0.4	3.0	22.2	460

Purging Sampling Rates Purged @ 240 Hz, flow @ 3 gpm. Water looks clear within 10 min.

Well Condition: OK

Additional Information/Comments: _____

Flow - 4



BRYAN A. STIRRAT & ASSOCIATES

GROUNDWATER MONITORING PROGRAM WELL DATA SHEET

SITE: SHWS

Well No.:	<u>LEO-11A</u>	Sampling Date:	<u>3/17/08</u>
Collected By:	<u>JNB</u>	Purge Start Time:	_____
Casing Diameter (inches):	<u>2</u>	Purge Stop Time:	_____
Bubbler Reading:	_____	Sampling Time:	<u>1300</u>
Starting Water Level (feet):	<u>53.71</u>	Ending Water Level (feet):	<u>54.34</u>
Total Depth (feet):	<u>64.0</u>	Total Purged (gallons):	<u>0</u>
Water Column (feet):	_____	Counter - Cycles to Fresh H ₂ O:	_____
Screen Length (feet):	_____	Horiba Model S/N:	<u>302030</u>
3 Well Volumes (gallons):	_____	Control Box #:	_____
		Duplicate Sample:	Yes <input type="checkbox"/> No <input checked="" type="checkbox"/>

HydraSleeve
Depth

Gallons Purged	Water Level	pH	Conductivity ms/cm	Turbidity NTU	D.O. mg/L	Temperature °C
55	—	Dry	—	—	—	—
58	—	Insufficient water to sample				—
61	^{JNB} 7.1	7.1	0.38	50.2	—	18.6

Purging Sampling Rates Removal rate < 0.5 ft/sec

Well Condition: Good

Additional Information/Comments: The 55'-56.5' interval was dry.



BRYAN A. STIRRAT & ASSOCIATES

GROUNDWATER MONITORING PROGRAM WELL DATA SHEET

SITE: SHWS

Well No.: FC-1020A
 Collected By: JNB
 Casing Diameter (inches): 4
 Bubbler Reading: _____
 Starting Water Level (feet): 12.31
 Total Depth (feet): 100.20
 Water Column (feet): _____
 Screen Length (feet): _____
 3 Well Volumes (gallons): _____

Sampling Date: 3/17/08
 Purge Start Time: 1400
 Purge Stop Time: _____
 Sampling Time: _____
 Ending Water Level (feet): 12.33
 Total Purged (gallons): Ø
 Counter - Cycles to Fresh H₂O: _____
 Horiba Model S/N: 302030
 Control Box #: _____
 Duplicate Sample: Yes No

HydraSleeve
Depth

Gallons Purged	Water Level	pH	Conductivity ms/cm	Turbidity NTU	D.O. mg/L	Temperature °C
35						
40		6.7	0.56	47.5	11.1	20
45		6.2	0.58	24.8	10.1	18.7
50		6.5	0.63	54.0	9.9	18.2

Purging Sampling Rates Removal rate < 0.5 ft/sec

Well Condition: Good

Additional Information/Comments: _____